


Section 9 Township 25 Range 4WWell No. 1 Meyer "A"Company Mid-States Oil Corp.

NORTH

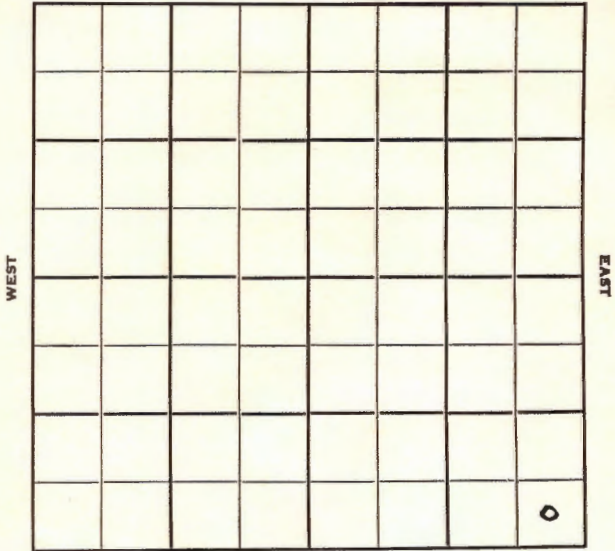

SOUTH

Reno

KANSAS 4W

Sec. 9 Twp. 25 R. 4W

Well No. #1 Meyer "A" Farm

Mid-States Oil Corp. Company

Anschutz Drlg. - Contr. Contractor

Wildcat


_____ Ft. from N. Line

NORTH

330' Ft. from S. Line

330' Ft. from E. Line

_____ Ft. from W. Line

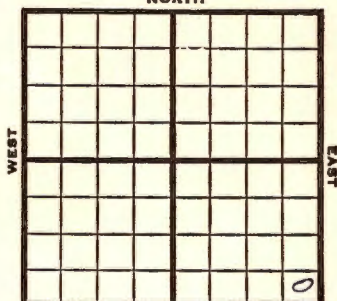

SOUTH

SE SE SE

1951

Elev. 1482' REPORT

7/18
10/31

RUR

Spud 7-18-51

D&A TD 4130

10" @ 282

Br Lime 2707 **Lans. 2743**

BKC 3387 **Miss 3517**

DST 3519-41 opn $\frac{1}{2}$ hr Rec. 6' mud SSO

DST 3565-3620 opn 1 hr. Rec. 630'

sw **Kh 3828** **Hunton 3870**

Maq. 3928 **Viola 3962**

Simp 3977-4022 **Arb. 4077**

DST 3966-76 opn $\frac{1}{2}$ hr Rec. 7' mud

DST 4077-81 opn $1\frac{1}{2}$ hr. Rec. 360' sw

DST 4082-4130 opn 1 hr Rec. 3480'

sw TD 4130 12/3978-81 FU 2950'

fluid B/12 bfph 20/3977-81 B/10

bo P/66 bo 123 bw 14 hr.

P/67 bo 176 bw 24 hrs. CO to 4130

12/3978-79 12/3979-80 FU 1680'


fluid 6 hrs.

P 144 bw 1 bo 12 hrs.

D&A

ABANDONED

County **Reno** State **Kansas**
 Sec. **9** (Blk.) **25** (Sur.) **4W** Map No.
 Operator **Mid-States Oil Corp.**
 Well No. **1** Farm **Meyer "A"**
 Elev. Location **SE SE SE**

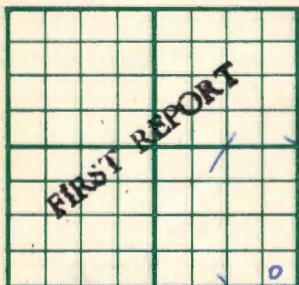

330 Ft. From **S** Line **SE**
330 Ft. From **E** Line Quarter

1st. Report **JUL 18 1951**

Completion

Remarks

Anschutz Drlg. - Contr.

Spudding Date


Drlg. Data

Wildcat

RUR

J. E. TYRA

County Reno State Kansas
 Sec. 9 (Blk. 25) (Sur. 4W) Map No.
 Operator Mid-States Oil Corp.
 Well No. 1 Farm Meyer "A"
 Elev. 1482 Location SE SE SE

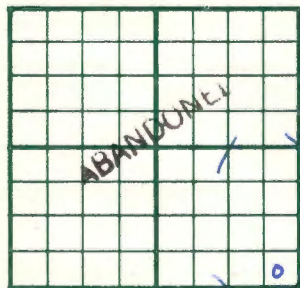

330 Ft. From S Line SE

330 Ft. From E Line Quarter

1st. Report

Completion OCT 31 1951Remarks WildcatAnschutz Drlg. - Contr.Spudding Date 7-18-51Drlg. Data D & A TD 413010" @ 282 Br. lime 2707 Lans. 2743B. KC 3387 Miss. 3517 DST 3519-41open $\frac{1}{2}$ hr. Rec. 6' mud SSODST 3565-3620 open 1 hr. Rec. 630' swKh. 3828 Hunton 3870 Mag. 3928Viola 3962 Simp. 3977-4022 Arb. 4077DST 3968-76 open $\frac{1}{2}$ hr. Rec. 7' mudDST 4077-81 open $1\frac{1}{2}$ hr. Rec. 360' swDST 4082-4130 open 1 hr. Rec. 3480' swTD 4130 12/ 3978-81 FU 2950' fluidB/ 12 bfph 20/ 3977-81 B/ 10 boP/ 66 bo 123 bw 14 hr. P/ 67 bo 176 bw24 hr. CO to 4130 12/ 3978-7912/ 3979-80 FU 1680' fluid 6 hr.

J. E. TYRA

Drlg. Data

P/ 144 bw 1 bo 12 hr.

D & A

Misc.

Pierce Map

France Map

Tracings

Land Wall Map

Land Small Map

Scout Cards

14 AUG 1941