


Section 15 Township 25 Range 4W

Well No. #1 Meyer

Company Durbin Bond

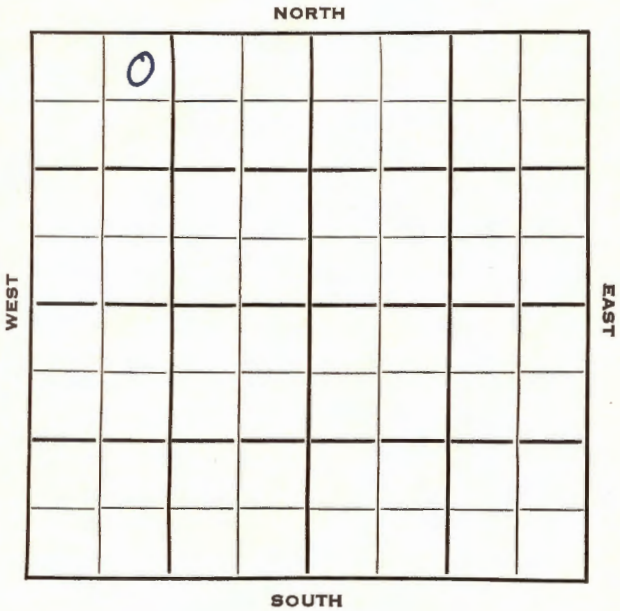

Sec. 15 Twp. 25 R. 14W

Well No. #1 Meyer Farm

Durbin Bond Company

Sterling Drlg. Contractor


Haven Pool

330 Ft. from N. Line

_____ Ft. from S. Line

_____ Ft. from E. Line

990 Ft. from W. Line

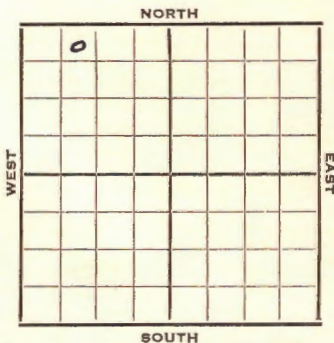

NE NW NW

Amstutz & Yates, Geol.

Mid-States F/O

1953 **Elev. 1478'**

REPORT

7/8 Spud 7-4-53
8" @ 283' w/175 sks

7/22 Drlg 975'
Spud 7-4-53
D & A
TD 4100'
8" @ 283'

**Br. Lime 2711, Lans 2757, Miss 3536,
Osage 3591, Kh. 3840, Maq 3939, Viola
3980, Simp 3991, Arb 4086
TD 4100
D & A**

ABANDONED

County Reno State Kansas

Sec. 15 (Blk. 25) (Sur. 4W) Twp. 25 Map No.

Operator Durbin Bond

Well No. 1 Farm Meyer

Elev. Location NE NW NW

0					

FIRST REPORT

330 Ft. From N Line NW

990 Ft. From W Line Quarter

1st. Report JUL 8 1953

Completion

Remarks Amstutz & Yates, Geol.
Mid-States - 70

Sterling Drlg. - Contr.

Spudding Date 7-4-53

Drlg. Data Haven - pool

8" @ 283 w/175 Drlg. 975

J. G. MCGHEE

County Reno State Kansas

Sec. 15 (Blk. Twp.) 25 (Sur. Rge.) 4W Map No.

Operator Durbin Bond

Well No. 1 Farm Meyer

Elev. 1478 Location NE NW NW

o					

330 Ft. From N Line NW
990 Ft. From W Line Quarter

1st. Report

Completion JUL 2 1953

Remarks Haven Pool

Sterling Drlg. - Contr.

Spudding Date 7-4-53

Drlg. Data D & A TD 4100

8" @ 283 Br. line 2711 Lans. 2757

Miss. 3536 Osage 3591 Kh. 3840

Maq. 3939 Viola 3980 Simp. 3991

Arb. 4086 TD 4100

D & A