

Reno

KANSAS

FORM 51 25M 3-49 PETROL

Section 16 Township 25 Range 4W

Well No. #1 Schlickaw (B)

Company Mid-States

NORTH

WEST

EAST

						0	

SOUTH

Reno

KANSAS



Sec. 16 Twp. 25 R. 4 W

Well No. # 1 Schlickaw (B) Farm

Mid-States Company

Gabbert & Jones Contractor

Haven


330 Ft. from N. Line

_____ Ft. from S. Line

990 Ft. from E. Line

_____ Ft. from W. Line

NW NE NE

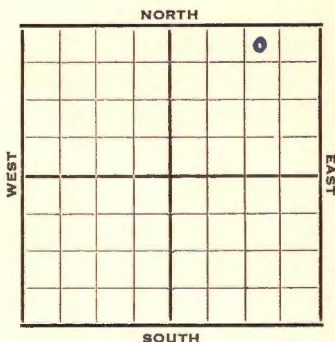

1952

Elev. 1486

REPORT

7/16

Location

7/23

MIR

7/30

8" @ 247'

Drlg. 2692'

8/6

Heeb. 2527 Br Li 2712

Lans. 2750 Drlg. 3240

8/13

Miss Warsaw 3519 Osage 3580

DST 3576-3626, 1 hr. 600' SW

980# Drlg. 3723'

8/20

Spud 7-23-52 D&A TD 4124

8" @ 247 **Heeb. 2527 Br Lime 2712**

Lans. 2750 Miss Warsaw 3519

Osage 3580

DST 3576-3626 opn 1 hr. Rec. 600' sw

980# **Kh 3838 Maq. 3936**

DST 3936-42 opn 1 hr. Rec. 8' mud Off.

Viola 3975 Simp 3990

DST 3989-92 opn 1 hr. Rec. 900'

wtr cushion 1390# DST 3987-94

opn 1/2 hr. Rec. 900' wtr cushion

1200' sw 1390# **Arb. 4089**

TD 4124 D&A

ABANDONED

