

Reno


KANSAS

FORM 51 5M 4-41 PETROL

Section 30 Township 25 Range 4-W

Well No. #1 Soper

Company Rockett Drilling

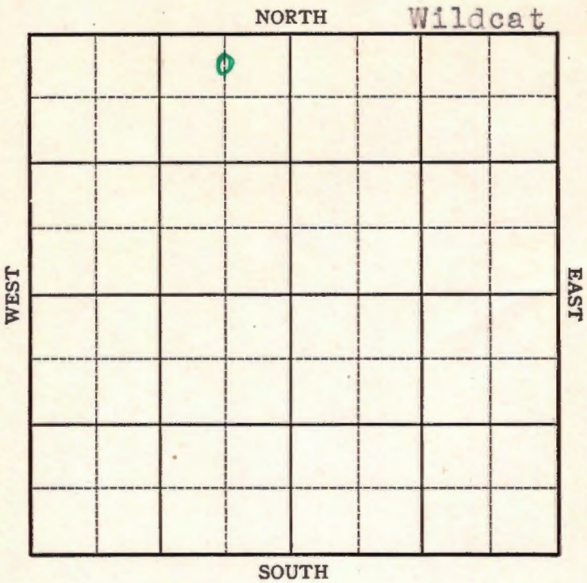

Sec. 30 Twp. 25 R. 4-WWell No. #1 Soper FarmRocket Drilling Company


(Wildcat)

330 Ft. from N. Line

Ft. from S. Line

660 Ft. from E. Line

Ft. from W. Line

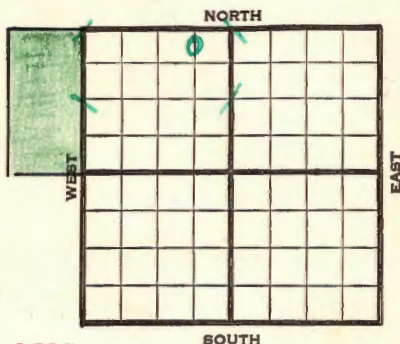Elev. ~~1313~~ 1525

1941	REPORT O.W.D.D.
10/15	S. H.
10/23	10" - 180' Ft. Riley 1010'
	Base Florence 1145'
	Drlg. 1950'
10/30	Topeka 2205' Lans. 2812'
	Drlg. 3255'
11/6	Miss. 3539' Drlg. 3715'
11/13	Viola 3981-86' T.D.
	4" - 3981' RUST. S.O.
11/15	Drilled plugs Filled up 900 feet oil in 5 hours Still filling up (Tel)
11/19	Total fill up 1400 feet oil--time not given Acid 500 gallons--no help Acidized 750 gallons Swab 25 bbls. net oil 1st hour Made 1 small flow Hole filling up at rate of 35 bbls. per hour No water Grav. 38.3 (Tel)
11/26	Swab 141 oil in 13 hours 800' off bottom. Shut down.
12/4	Run csg. pump.
	OVER

12/10--Pumping potential 456 bbls. No water
Couldn't pump fast enough
Will put in another pump (Tel)

12/17 **Viola 3981**
4" @ 3981

1250 acid
Pump 495 Potential
TD 3986

Grav. 39.8

COMPLETED

1942
3/18

O. W. D. D.

Old T.D. 3986'
Old potential 495 bbls.,
Pump dry.
Simpson 3992'
Drilled to 4029'
T.D. 4029' 1700' water.

FIRST REPORT

and

ABANDONED


Map No. X-40 Sec. 30 Twp. 25 R. 4WWell No. 1 SoperRocket Drilling CompanyFIRST REPORT Contractor

C NL NE NW

330 Ft. from N. Line Ft. from S. Line660 Ft. from E. Line Ft. from W. Line

WILDCAT

SECTION PLAT

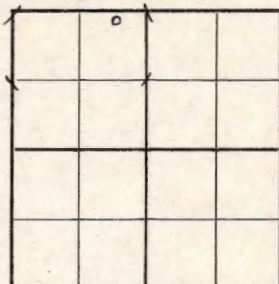Location Rig up Drilling and Remarks:

S.H.

RECORD

Cased in., ft.Sand Gas Oil Total Depth

PRODUCTION

1st 24 hrs. Nat. 1st 24 hrs. after shot Gas Cu. Ft.Dry Hole Abandoned

Date

OCT 15 1941

19

S. J. LEWIS Scout

Reno

KANSAS

Map No. 40 Sec. 30 Twp. 25 R. 4WWell No. 1 SoperRocket Drilling CompanyCOMPLETED Contractor

C NL NE NW

330 Ft. from N. Line

Ft. from S. Line

660 Ft. from E. Line

Ft. from W. Line

SECTION PLAT

WILDCAT

Location _____

Rig up _____

Drilling and Remarks:


RECORD

Cased _____ in., _____ ft.

Sand _____

Gas _____

Oil _____


PRODUCTION

1st 24 hrs. Nat. _____

1st 24 hrs. after shot _____

Gas _____ Cu. Ft.

Dry Hole _____

Abandoned _____

Date

DEC 17 1941 19

S. J. LEWIS Scout

Rent

KANSAS

Map No. 40 Sec. 30 Twp. 25 R. 4WWell No. 1 Soper

Rocket Drilling

Company

FIRST REPORT

Contractor

ABANDONED

C NL NE NW


330 Ft. from N. Line

Ft. from S. Line

660 Ft. from E. Line

Ft. from W. Line

SECTION PLAT

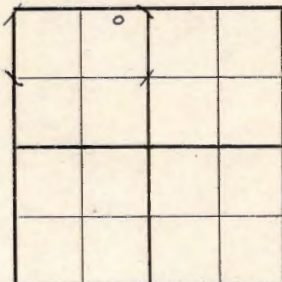

FRIENDSHIP POOL

Location

Rig up

Drilling and Remarks:

O.W.D.D.

Old T.D. 3986'

Old Pot. 495'

Pump Dry

Simpson 3982'

drilled to 4029'

1700' Water

RECORD

Cased _____ in., _____ ft.

Sand _____

Gas _____

Oil _____

Total Depth 4029'

PRODUCTION

1st 24 hrs. Nat. _____

1st 24 hrs. after shot _____

Gas _____ Cu. Ft.

Dry Hole _____

Abandoned _____

Date

MAR 1 8 1942

19

S. J. LEWIS Scout