


Section 30 Township 25 Range 4-WWell No. #1 O. SoperCompany Bradley & Beardmore

NORTH

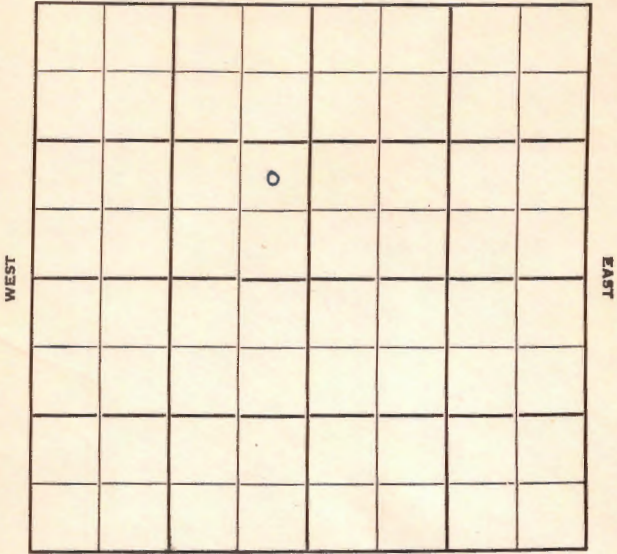

SOUTH

Reno

KANSAS

Sec. 30 Twp. 26-23 R. 4W ✓

Well No. #1 O. Soper Farm

Bradley & Beardmore Company

Contractor

Wildcat


Ft. from N. Line

990' Ft. from S. Line

330' Ft. from E. Line

Ft. from W. Line

NE SE NW

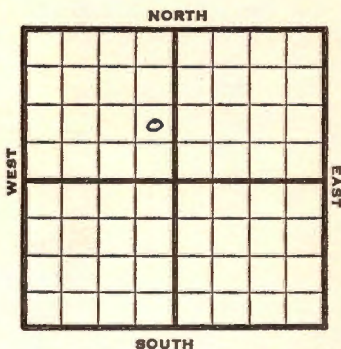

1950

Elev 1530

REPORT

8/9

Location

9/27

Spud 9-9-50

8 5/8" @ 199

Heeb 2934

Lans 2981

Cong 3556

Miss 3561

Kinderhook 3821

Viola dol 3986

Simp 4001

Simp sd 4003

DST 4003-06 open 15 minrec 10' mud

Arb 4095-4127 TD

TD 4127

D&A

ABANDONED

County **Reno** State **Kansas**

Sec. **30** (Blk. **25** (Sur. **4W** Map No.

Operator **Bradley & Beardmore**

Well No. 1 Farm O. Soper

Elev.	Location	NE	SE	NW
990 Ft. From 8 Line NW

330 Ft. From Line Quarter

1st. Report SEP 6 1950

Completion

Remarks	Core drill
---------	------------

Phillips acreage & DEM

Spudding Date _____

Drig. Data Wildcat

Location

J. E. TYRA

County Reno State KansasSec. 30 (Blk.
Twp.) 25 (Sur.
Rge.) 4W Map No.Operator Bradley & BeardmoreWell No. 1 Farm O. SoperElev. 1530 Location NE SE NW990 Ft. From S Line NW330 Ft. From E Line Quarter

1st. Report

Completion SEP 27 1950

Remarks

Spudding Date 9-9-50Drlg. Data D & A TD 41278 5/8" @ 199 Heeb. 2934 Lans. 2981Cong. 3556 Miss. 3561 Kinderhook 3821Viola dol. 3986 Simp. 4001 Simp. sd.4003 DST 4003-06 open 15 min.Rec. 10' mud Arb. 4095-4127 TDD & A

J. E. TYRA