

DX 78-1


Hamilton

KANSAS

Section 5 Township 25 Range 42W

Well No. #1 Barnett

Company Sinclair O & G

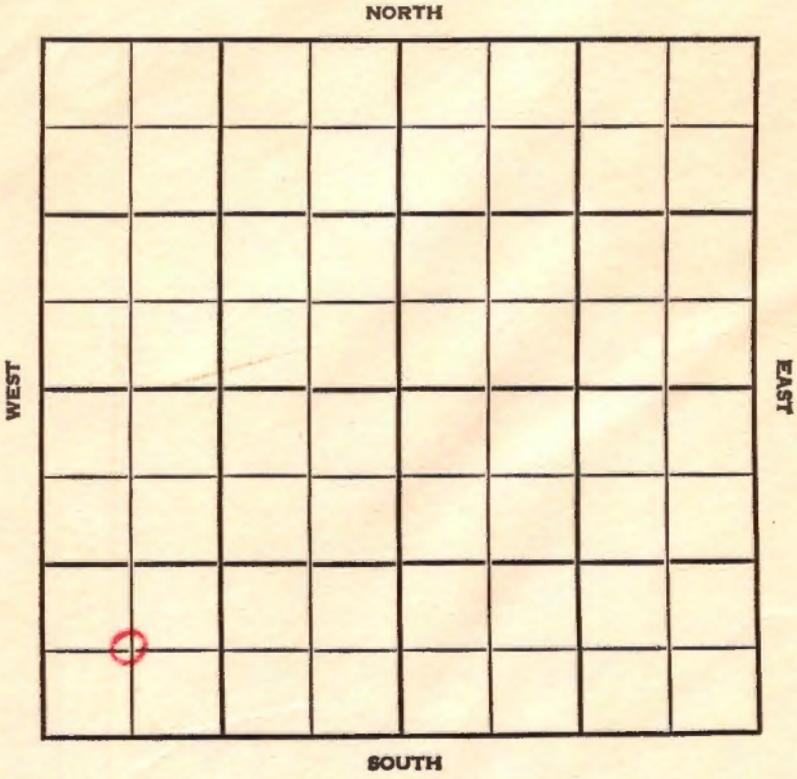

Hamilton

**HOT FILE KANSAS**

SEC.	TWP.	R.
5	25	42W

WELL NO.

1 Barnett

FARM

COMPANY

Sinclair O &amp; G

CONTRACTOR

Helfrich Pool

Ft. from N. Line

660'

Ft. from S. Line


Ft. from E. Line

660'

Ft. from W. Line

C SW SW

Offset SDX

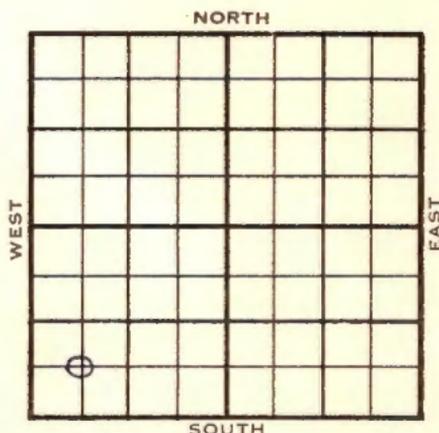

1955

ELEVATION

REPORT

5/25

Location

6/2

Moving in material

6/9

Spud 6-6-55

13-3/8" @ 565 w/400 WOC

6/16

8-5/8" @ 2689 w/500

Drlg. 2695'

6/23

Top 3475', Heebner 3782', Lans 3815'

Drlg. 4329'

6/30

Cored 5045-56, full rec., cored 5055-72, full rec., Miss. 5336, drlg. 5373

7/7

13 3/8" @ 565/400 8 5/8" @ 2689/500

D&amp;A

Tops:	Depth	Log	Datum
Tp.	3475	3475	
H.	3782	3772	
L.	3815	3804	211
KCMarm		4364	771
BKC Morrow		5046	1453
M.	5336	5338	1745
TD.	5495		

**ABANDONED**

County Hamilton State Kansas

Sec. 5 (Blk. Twp.) 25 (Sur. Rge.) 42W Map No.

Operator Sinclair O & G

Well No. 1 Farm Barnett

Elev. \_\_\_\_\_ Location C SW SW



**FIRST REPORT**

660 Ft. From S Line SW

660 Ft. From W Line Quarter

1st. Report MAY 25 1955

Completion \_\_\_\_\_

Remarks \_\_\_\_\_

Spudding Date \_\_\_\_\_

Drlg. Data Helfrich Pool

Location \_\_\_\_\_

**K-34**

County Hamilton Elev. 3593  
 Sec. 5 Twp. 25 Rge. 42W  
 Company Sinclair O & G  
 Farm Name Barnett No. 1

TOPS	DEPTH	LOG	DATUM
Anh.			
Tp.	<u>3475</u>	<u>3475</u>	
H.	<u>3782</u>	<u>3772</u>	
Tr.			
Dg.			
Bl.			
L.	<u>3815</u>	<u>3804</u>	<u>311</u>
K.C. <u>norm</u>		<u>4364</u>	<u>1771</u>
B.K.C. <u>norm</u>		<u>5040</u>	<u>1753</u>
Ce.			
C.			
M.	<u>5336</u>	<u>5338</u>	<u>1745</u>
M.			
K.			
Mz.			
Me.			
V.			
S.			
S.			
A.			
R.			
Pe.			
G.			
T.D.	<u>5495</u>		

Loc. in Sec. C SW SW  
 Geol. \_\_\_\_\_  
 Contr. \_\_\_\_\_  
 Pool Garvey  
Helfrich  
**ABANDONED**  
 JUL 6 1955

Date Comm. 6-6-55  
13 3/8" @ 565/400 8 5/8" @ 2689/500

D & A

Co.  
 Lse.  
 No.  
 Sec.  
 T.  
 R.