

Section 6 Township 25 Range 42W


Well No. #2 Frank Helfrich

Company United Carbon

NORTH

WEST

EAST

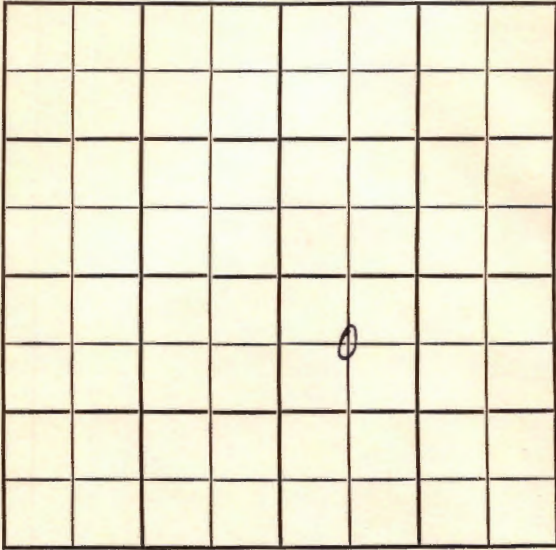

SOUTH

HOT FILE

Hamilton KANSAS


SEC.	TWP.	R.
6	25	42W

WELL NO. **2 Frank Helfrich** FARM

COMPANY **United Carbon**

CONTRACTOR **Hartman & Hartman
Helfrich Pool**

660 _____ Ft. from N. Line
 _____ Ft. from S. Line
 _____ Ft. from E. Line
 660 _____ Ft. from W. Line

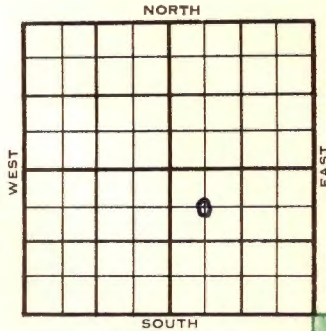

C NW SE

	ELEVATION	REPORT
1955	3567'	
3/23	Spud 3-20-55 Drlg. 600'	
4/7	Set 8" @ 2268' 8" parted, Shut down.	(Sct. Ltr.)
4/14	Drlg. 4180'	"
4/21	Cored 4991-5014', rec 23' sd & sh DST 4992-5014, open 45 min, died in 7 min, rec 95' mud. 170#.	
4/28	Dflg. ahead. D & A.	(Ltr-Gilstrap) "
4/27	Spud 3-20-55 - D&A TD 5360' 13" @ 600' 8" @ 2268' DST 4992-5014', opn 45", died in 7", rec. 95' mud, 170# TD 5360' DST 5252-5360', opn 45", rec. 165' mud, 255#	
	Schl Tops: Top. 3415', Heeb. 3730', Lans. 3767', Marm. 4504', Cherokee 4706', Atoka 4894', Morrow sh. 4976', Morrow sd 4985'	
	D&A	

ABANDONED

County Hamilton State Kansas

Sec. 6 (Blk. Twp.) 25 (Sur. Rge.) 42W Map No.

Operator United Carbon

Well No. 2 Farm Frank Helfrich

Elev. 3567 Location C NW SE



660 Ft. From N Line SE

660 Ft. From W Line Quarter

1st. Report

Completion APR 27 1955

Remarks Helfrich Pool

Hartman & Hartman - Contr

Spudding Date 3-20-55

Drig. Data D & A TD 5360

13" @ 600 8" @ 2268 DST 4992-5014

open 45 min. died in 7 min. Rec. 95' mud

170# TD 5360 DST 5252-5360 open

45 min. Rec. 165' mud 255#

SCHLUMBERGER TOPS:

Top. 3415 Heeb. 3730 Lans. 3767

Marm. 4504 Cherokee 4706 Atoka 4894

Morrow sh. 4976 Morrow sd. 4985

D & A

K-34