


DX 78-1

Section 6 Township 25 Range 42 W
Well No. #3 Frank Helfrick (Helfrich)
Company United Production

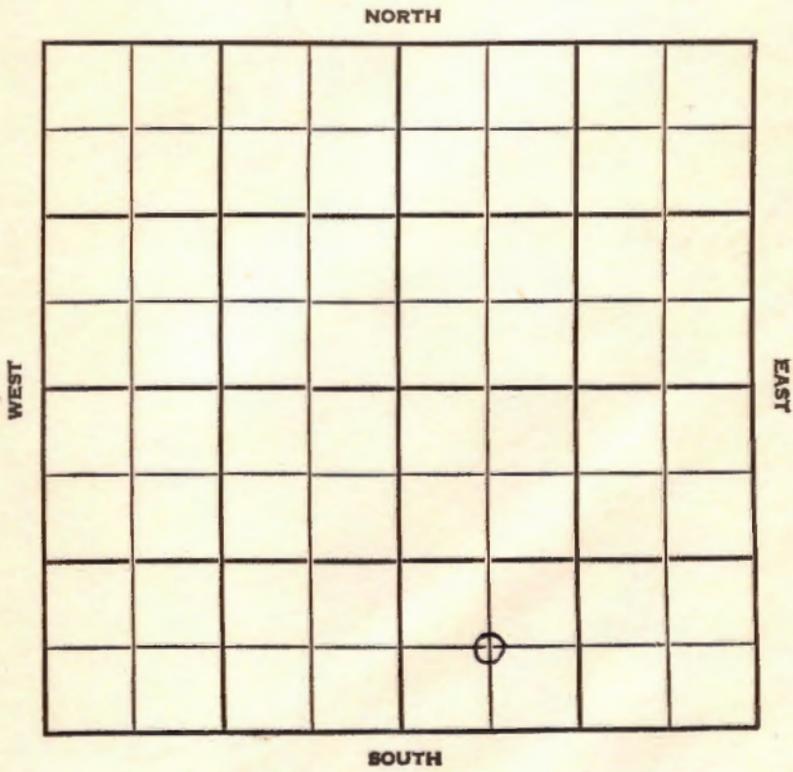

Hamilton

KANSAS

SEC.	TWP.	R.
6	25	42W

WELL NO. #3 Frank Helfrich FARM

COMPANY United Production

CONTRACTOR Rine Drlg


Helfrich

_____ Ft. from N. Line

_____ Ft. from S. Line

_____ Ft. from E. Line

_____ Ft. from W. Line

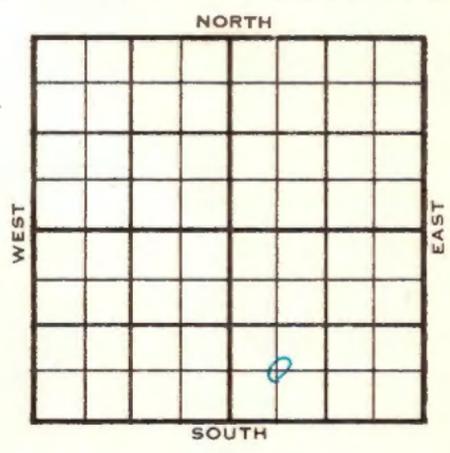

C SW SE

1955	ELEVATION 3598'	REPORT
------	--------------------	--------

10/5 Comm 10-2-55
Drlg 625

11/2 Comm 10-2-55
13" @ 606/500

Cimm		1860
Chase		3172
Top		3435
Heeb		3764
L ₂ ns		3790
Marm	3481	4581
Ce	4530	4730
Morrow		4944
2nd sd		5145

D & A

ABANDONED

County Hamilton Elev. _____
 Sec. 6 Twp. 25 Rge. 42W
 Company United Production
 Farm Name Frank Helfrich No. 3

TOPS	DEPTH	LOG	DATUM	Loc. in Sec.
Anb.				C SW SE
Tr.				
H.				
Tr.				
Dg.				
Bl.				
L.				Geol. _____
K.C.				Contr _____
B.K.C.				
Ce.				<u>Pine Drlg.</u>
C.				
M.				Pool _____
M.				<u>Helfrich</u>
K.				
Mz.				
Me.				
V.				
S.				
S.				
A.				
R.				
Pe.				
G.				
T.D.				



Date Comm. 10-2-55

drlg. 625

~~39~~

Co.
No.
Sec.
T.
R.

County Hamilton Elev. 3598

Sec. 6 Twp. 25 Rge. 42W

Company United Production

Farm Name Frank Helfrich No. 3

TOPS	DEPTH	LOG	DATUM
Anh.			
TP.			
H.			
Tr.			
Dg. <u>Cinnon</u>		<u>1860</u>	
Bl. <u>Chase</u>		<u>3172</u>	
L. <u>John</u>		<u>3435</u>	
K.C. <u>Helfr</u>		<u>3764</u>	<u>1666</u>
B.K.C. <u>Sassa</u>		<u>3790</u>	<u>192</u>
Ce. <u>Mason</u>		<u>4581</u>	<u>983</u>
C. <u>Ce</u>		<u>4730</u>	<u>1132</u>
M. <u>Morrow</u>		<u>4944</u>	<u>1346</u>
M. <u>2nd sd.</u>		<u>5145</u>	<u>1547</u>
K.			
Mz.			
Me.			
V.			
S.			
S.			
A.			
R.			
PE.			
G.			
T.D.			

Loc. in Sec. C SW SE

Geol. _____

Contr. _____

Rine Drlg.

Pool

Helfrich

ABANDONED

Date Comm. 10-2-55

NOV 2 1955

13" @ 606/500

D & A

Co.

Sec.

No.

Sec.

T.

R.