

RELEASED

SIDE ONE

3/22/86
3-22-87
KCC

DATE APR 1 1987
STATE CORPORATION COMMISSION OF KANSAS
OIL & GAS CONSERVATION DIVISION
FROM CONFIDENTIAL

WELL COMPLETION OR RECOMPLETION FORM
ACO-1 WELL HISTORY

DESCRIPTION OF WELL AND LEASE

Operator: License # 4270
Name Barrett Resources
Address 221 E. 29th Suite 240
City/State/Zip Loveland, CO 80537

Purchaser.....

Operator Contact Person Merle Evers
Phone (303) 669-2211

Contractor: License # 5382
Name Cheyenne Drlg

Wellsite Geologist John Fontana
Phone (303) 863-0014

Designate Type of Completion

- New Well
- Re-Entry
- Workover
- Oil
- Gas
- Dry
- SWD
- Inj
- Other (Core, Water Supply etc.)
- Temp Abd
- Delayed Comp.

If OWWO: old well info as follows:

Operator.....
Well Name.....
Comp. Date.....Old Total Depth.....

WELL HISTORY

Drilling Method:

- Mud Rotary
- Air Rotary
- Cable

12-11-85 12-22-85

Spud Date Date Reached TD Completion Date

5901'

Total Depth PBDT

Amount of Surface Pipe Set and Cemented at 852 feet

Multiple Stage Cementing Collar Used? Yes No

If yes, show depth set.....feet

If alternate 2 completion, cement circulated from.....feet depth to.....w/.....SX cmt

API NO. 15-.....075-20401.....

County.....Hamilton.....

SW NE/4..... Sec.3... Twp..25S Rge..43... East West

3300..... Ft North from Southeast Corner of Section

1980..... Ft West from Southeast Corner of Section

(Note: Locate well in section plat below)


Lease Name.....Schwardfeger.....Well #..1-3..

Field Name.....

Producing Formation.....

Elevation: Ground.....3600.....KB.....

Section Plat

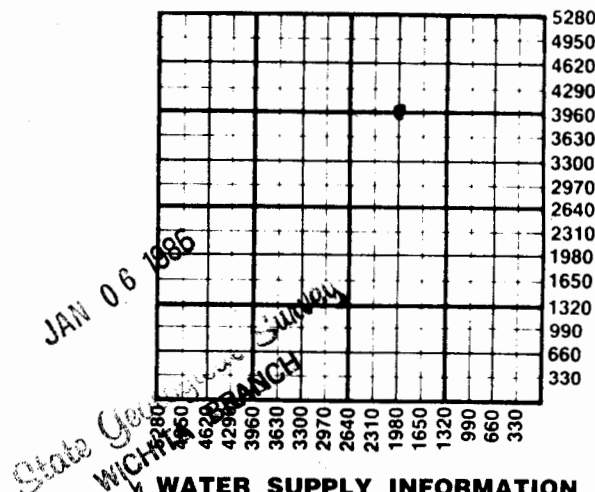

WATER SUPPLY INFORMATION

Disposition of Produced Water: Disposal Repressuring

Docket #

Questions on this portion of the ACO-1 call:

Water Resources Board (913) 296-3717

Source of Water:

Division of Water Resources Permit #...T85-996....

Groundwater...1980 Ft North from Southeast Corner (Well) ...1980 Ft West from Southeast Corner of Sec 3 Twp 25S Rge 43 East West

Surface Water.....Ft North from Southeast Corner (Stream, pond etc).....Ft West from Southeast Corner Sec Twp Rge East West

Other (explain).....
(purchased from city, R.W.D. #)

INSTRUCTIONS: This form shall be completed in duplicate and filed with the Kansas Corporation Commission, 200 Colorado Derby Building, Wichita, Kansas 67202, within 90 days after completion or recompletion of any well. Rule 82-3-130 and 82-3-107 apply.

Information on side two of this form will be held confidential for a period of 12 months if requested in writing and submitted with the form. See rule 82-3-107 for confidentiality in excess of 12 months. One copy of all wireline logs and drillers time log shall be attached with this form. Submit CP-4 form with all plugged wells. Submit CP-111 form with all temporarily abandoned wells.

Barrett Energy Company
Schwerdfeger #1-3
Section 3 - T25S - R43W
Hamilton County, Kansas

SWNE

Commenced: 12-11-85
Completed: 12-27-85

Surface Casing: 842' of 8-5/8" casing.
Cmtd w/340 sx DSLW6S, 2% cc, 100 sx
standard, 3% cc.

FORMATION

DEPTH

Surface Hole
Sand, Red Bed
Sand, Shale
Sand
Shale, Red Bed
Shale
Shale, Lime
Lime, Shale
Lime
Morrow
Shale
Lime, Shale
Mississippian

0 - 852
852 - 1130
1130 - 1685
1685 - 1885
1885 - 2265
2265 - 2785
2785 - 3020
3020 - 3500
3500 - 4995
4995 - 5055
5055 - 5210
5210 - 5655
5655 - 5901 RTD

06 1986
Geological Survey
MICHINA BRANCH

RECEIVED
STATE CORPORATION COMMISSION
JAN 6 1986
CONSERVATION DIVISION
MICHINA BRANCH

I do hereby certify that the foregoing statements are true and correct to the best of my knowledge and belief.

CHEYENNE DRILLING, INC.

A. J. Jacques

A. J. Jacques

STATE OF KANSAS: ss:

Subscribed and sworn to before me this 30th day of December 19 85.

NOTARY PUBLIC - State of Kansas
SHARYN K. COATES
My Appt. Exp. 3-18-89

Sharyn K. Coates
Sharyn K. Coates, Notary Public