

Section 5 Township 25 Range 5W

Well No. 1 Haines

Company Huber et al

Wildcat
NORTH

WEST

EAST

SOUTH

KANSAS

Reno

Sec. 5 Twp. 25 R. 5W ✓

Well No. #1 Haines Farm

Huber et al Company

Wildcat


 Ft. from N. Line

330' Ft. from S. Line

330' Ft. from E. Line

 Ft. from W. Line

SE SW

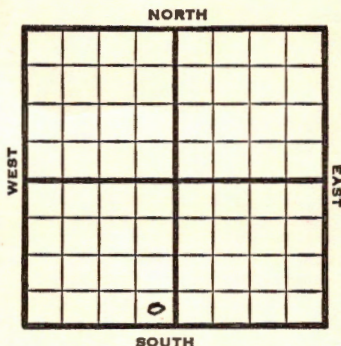

1949

Elev 1544'

REPORT

4/13 Location

4/20 8" @ 200'
Drlg. 2285'

4/27 **Miss 3448'**
Drlg. 3542'

5/4 TD 4003'
Viola 3857'
Arb. 3969'
Aband.

ABANDONED

Map No. _____ Sec. 5 Twp. 25 R. 5W

Well No. 1 Haines

Huber et al. Company

FIRST REPORT Contractor

SE SW

SECTION PLAT

_____ Ft. from N. Line

330 Ft. from S. Line

330 Ft. from E. Line

_____ Ft. from W. Line

Reno County

Location X

Rig up _____

Drilling and Remarks:

RECORD

Cased _____ in., _____ ft.

Sand _____

Gas _____

Oil _____

Total Depth _____

PRODUCTION

1st 24 hrs. Nat. _____

1st 24 hrs. after shot _____

Gas _____ Cu. Ft.

Dry Hole _____

Abandoned _____

Date

APR 13 1949

19

S. J. LEWIS

Scout

Map No. K40 Sec. 5 Twp. 25 R. 5W

Well No. 1 Haines

Huber et al. Company

ABANDONED

Contractor

SE SW

E1.1544

SECTION PLAT

 Ft. from N. Line

330 Ft. from S. Line

330 Ft. from E. Line

 Ft. from W. Line

Reno County

Location

Rig up

Drilling and Remarks:

W-10 380-7

Cur 3969

RECORD

Cased in., ft.

Sand

Gas

Oil

Total Depth 4000

PRODUCTION

1st 24 hrs. Nat.

1st 24 hrs. after shot

Gas Cu. Ft.

Dry Hole

Abandoned

Date

MAY 4 1949 19

S. J. LEWIS

Scout