


*Reno*

Map No. **KANSAS** Sec. *26* Twp. *25* R. *5*<sup>*10*</sup>

Well No. *1 Wilson* Farm  
*Regina O & G* Company

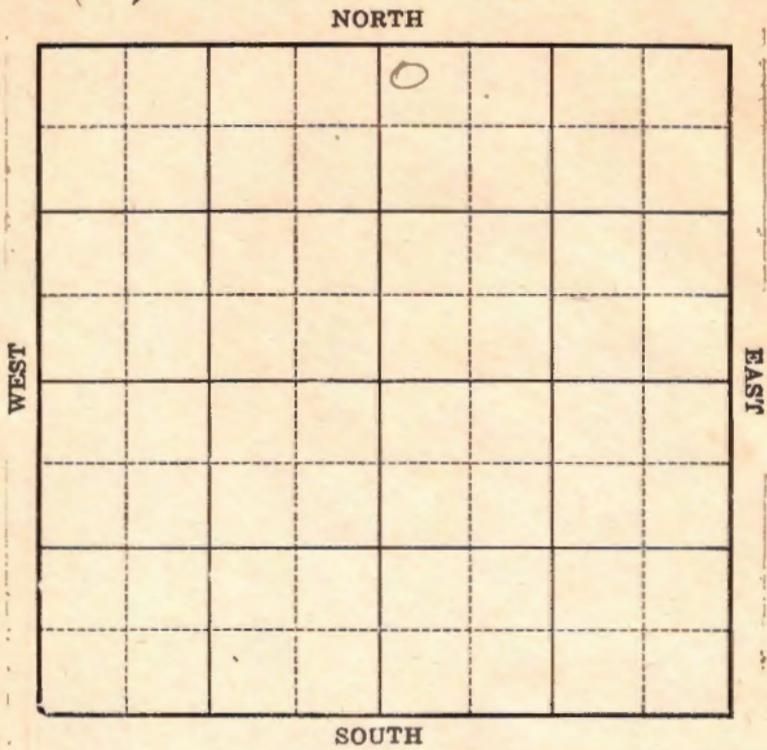

Location \_\_\_\_\_

Drilling Remarks \_\_\_\_\_

\_\_\_\_\_

\_\_\_\_\_

Rig Up \_\_\_\_\_

Drilling Remarks \_\_\_\_\_

\_\_\_\_\_

\_\_\_\_\_

**RECORD**

Cased \_\_\_\_\_ in. \_\_\_\_\_ ft.

Sand \_\_\_\_\_

Gas \_\_\_\_\_

Oil \_\_\_\_\_

Total Depth \_\_\_\_\_

**PRODUCTION**

1st 24 hrs. Nat. \_\_\_\_\_

1st 24 hrs. after shot \_\_\_\_\_

Gas \_\_\_\_\_ cu. ft.

Dry Hole \_\_\_\_\_

Abandoned \_\_\_\_\_

Map No. \_\_\_\_\_ Sec. 26 Twp 25 R. 5W

Well No. 1-Wilson Farm \_\_\_\_\_


Regina O. + G. Company

330 Ft. from N. Line

\_\_\_\_\_ Ft. from S. Line

\_\_\_\_\_ Ft. from E. Line

330 Ft. from W. Line

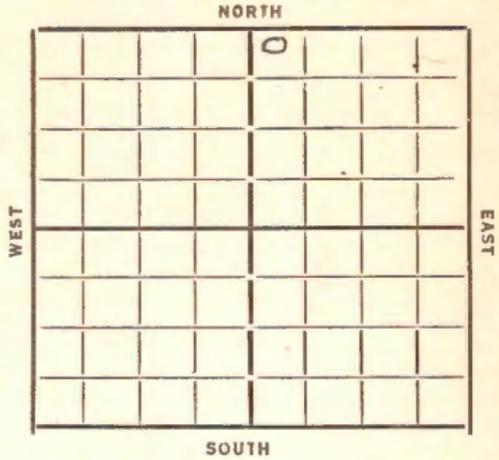

Date	REPORT
<u>1933</u>	
<u>8/30</u>	<u>Location</u>
<u>9/6</u>	<u>R.H. Rotary</u>
<u>9/13</u>	<u>—</u>
<u>9/20</u>	<u>15" - 110 &amp; D. 200</u>
<u>9/29</u>	<u>Drlog 2296</u>
<u>10/5</u>	<u>Top Lansing 2885 Drlog 3445</u>
<u>10/11</u>	<u>Miss 3617 - 8" at 3631</u>
<u>10/18</u>	<u>R.M.S.T.</u>
<u>10/25</u>	<u>8" at 3623 - TD 3650 - H.F.W 3650</u>
<u>11/1</u>	<u>Drlog 3813</u>
<u>11/8</u>	<u>6" at 3817 - Base Miss 3854</u>
	<u>Drlog 4008</u>
<u>11/15</u>	<u>Viola 4049</u>
	<u>Wilcox 4065</u>
	<u>Siliceous 4143 T.D.</u>
<u>11/22</u>	<u>Top Viola 4049</u>
	<u>Top Wilcox 4065</u>
	<u>Top Siliceous 4143</u>
	<u>D. + G. 4178</u>
	<b>ABANDONED</b>

Map No. 40 Sec. 26 Twp. 25 R. 5W

Well No. 1 - Wilson

Regina O & G Company

Contractor

**SPECIAL  
FIRST REPORTS**

**SECTION PLAT**

330 Ft. from N. Line

..... Ft. from S. Line

..... Ft. from E. Line

330 Ft. from W. Line

		0	

Location..... ✓

Rig up.....

Drilling and Remarks:

**RECORD**

Cased..... in., ..... ft.

Sand.....

Gas.....

Oil.....

Total Depth.....

**PRODUCTION**

1st 24 hrs. Nat.....

1st 24 hrs. after shot.....

Gas..... Cu. Ft.

Dry Hole.....

Abandoned.....

Date

8/30/33 192 O. Mansfield Scout

Map No. 40 Sec. 26 Twp. 25 R. 5W

Well No. 1- Wilson

Regina O & G. Company

Contractor

SECTION PLAT

330 Ft. from N. Line

..... Ft. from S. Line

..... Ft. from E. Line

330 Ft. from W. Line

**ABANDONED**


Location.....

Rig up.....

Drilling and Remarks:

Viola 4049  
Wilcox 4065  
Silicious 4143

O & A

RECORD

Cased.....in., .....ft.

Sand.....

Gas.....

Oil.....

Total Depth 4178

PRODUCTION

1st 24 hrs. Nat.....

1st 24 hrs. after shot.....

Gas.....Cu. Ft.

Dry Hole.....

Abandoned.....

Date

11-27-33 192

O. Mammuch Scout