
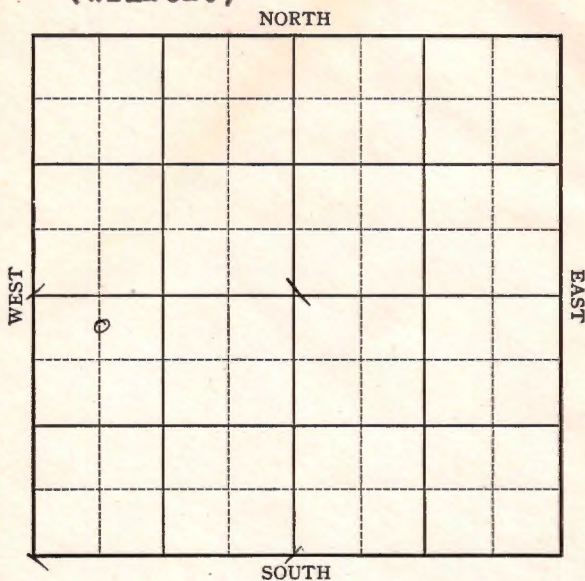


Section 31 Township 25 Range 5-W

Well No. #1 Stucky

Company Hall-Jordan
(Wild cat)

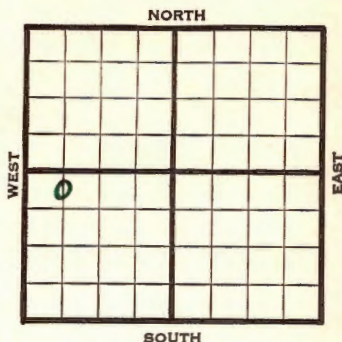

KANSASSec. 31 Twp. 25 R. 5-WWell No. #1 Stucky FarmHall-Jordan Company
(Wild cat)330' Ft. from N. Line Ft. from S. Line Ft. from E. Line660' Ft. from W. Line**Elev. 1460**

1941

REPORT

7/30

Location

8/7

Rot ary

8/15

10" 400 Dlg. 960

8/21

Lans. 2805' Drlg. 3110'

8/28

Miss. 3491' S.O. 3491-97'

Drlg. 3660'

9/3

Arb. 4019'

T.D. 4095'

No shows.

ABANDONED

KANSAS

Map No. 40 Sec. 31 Twp. 25 R. 5WWell No. 1 StuckyHall-Jordan Company


Contractor

FIRST REPORT

C N L NW SW

330 Ft. from N. Line Ft. from S. Line Ft. from E. Line660 Ft. from W. Line

SECTION PLAT

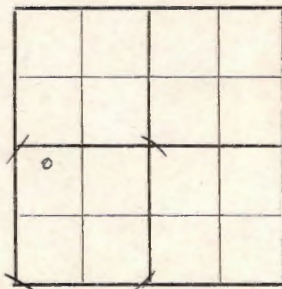

WILDCAT

Location XRig up

Drilling and Remarks:

RECORD

Cased in., ft.Sand Gas Oil Total Depth

PRODUCTION

1st 24 hrs. Nat. 1st 24 hrs. after shot Gas CDry Hole Abandoned

Date

JUL 30 1941

19

S. J. LEWIS

Map No. 40 Sec. 31 Twp. 25 R. 5WWell No. 1 StuckyHall-Jordan

Company

ABANDONED

Contractor


C N L NW SW

SECTION PLAT

330 Ft. from N. Line

Ft. from S. Line

Ft. from E. Line

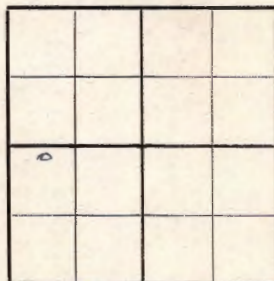660 Ft. from W. Line

WILDCAT

Location

Rig up

Drilling and Remarks:

*CR 84019**No shows*

RECORD

Cased _____ in., _____ ft.

Sand _____

Gas _____

Oil _____

Total Depth 4095

PRODUCTION

1st 24 hrs. Nat. _____

1st 24 hrs. after shot _____

Gas _____ Cu. Ft.

Dry Hole _____

Abandoned _____

Date

SEP 3 1941 19S. J. LEWIS Scout