

KANSAS


FORM 51 5M 4-41 PETROL

Stafford

Section 5 Township 25 Range 14N

Well No. 1-A Wilson

Company W. W. Drilling

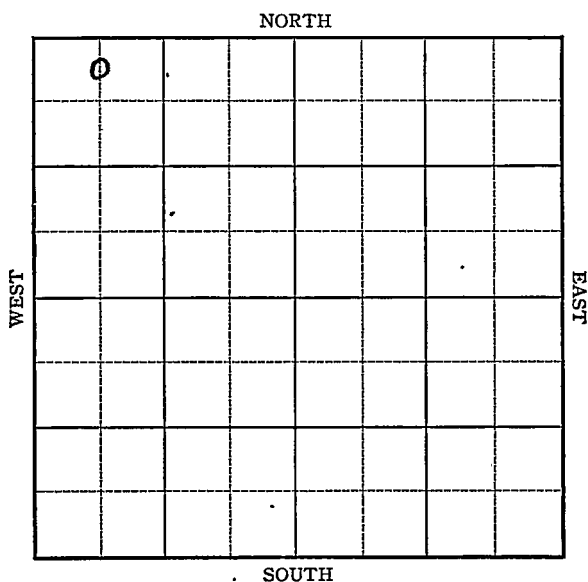


Sec. 5 Twp. 25 R. 14-WWell No. #1-A Wilson FarmW. W. Drilling Company

(Jordan)

330 Ft. from N. Line Ft. from S. Line Ft. from E. Line660 Ft. from W. Line

Elev. 1997

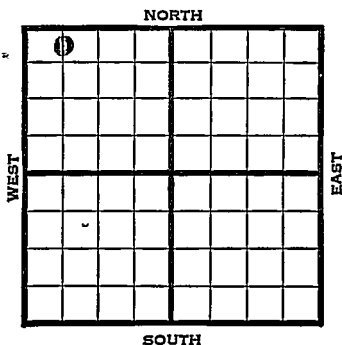

1941	REPORT
6/4	10" - 300' WOC.
6/12	Drlg. 1683'
6/19	Anhy 930' Drlg. 3200'
6/26	No report.
7/3	Viola 3758 ³⁷⁵⁸ 7" - 3948' RUST.
7/10	" "
7/17	Anhy 920' Topeka 3196'
	Lans. 3612' SO 3840 & 3906-20'
	Misener 3951' Viola 3958'
	T.D. 3967' 7" - 3948' RUST.
7/24	Shut down
7/31	Water & SSO.
8/7	TD 3971' 1000 acid PB 3965'
	10 qts. 3960-65
8/15	" "
8/21	" "
8/28	TD 3983' SD.
9/4	" "
9/11	" "
9/18	" "
9/25	" "
10/2	" "

OVER

1941
 10/9 TD 3983' SD.
 10/16 " "
 10/23 TD 4053' SD.
 10/30 5" liner at 4053'
 T.D. 4065' C.O.
 11/6 " " "
 11/13 4100' C.O. -
 11/20 Lime 4144' T.D. 4167'
 S.O. 4144-56'
 11/28 SD 4198'
 12/4 TD 4210'
 12/11 " "
 12/18 " "
 12/23 T.D. 4210' in Cong.
 Cannot get any correct dope.

ABANDONED

Map No. 83 Sec. 5 Twp. 25 R. 14WWell No. 1-A WilsonW. W. Drilling Company

Contractor

FIRST REPORT

SECTION PLAT

0			

330 C N L NW NW
Ft. from N. Line

Ft. from S. Line

Ft. from E. Line

660 Ft. from W. Line

JORDAN POOL

Location

Rig up

Drilling and Remarks:

10" - 300'
WOC

RECORD

Cased _____ in., _____ ft.

Sand _____

Gas _____

Oil _____

Total Depth _____

PRODUCTION

1st 24 hrs. Nat. _____

1st 24 hrs. after shot _____

Gas _____ Cu. Ft.

Dry Hole _____

Abandoned _____

Date

JUN 4 19419 S. J. LEWIS Scout

Stafford **KANSAS**Map No. 83 Sec. 5 Twp. 25 R. 14WWell No. 1-A WilsonW. W. Drilling CompanyABANDONED Contractor

C NL NW NW

330 Ft. from N. Line Ft. from S. Line Ft. from E. Line660 Ft. from W. Line

SECTION PLAT

2			

JORDAN POOL

Location Rig up

Drilling and Remarks:

in cong.
can not get
any. core & top

RECORD

Cased in., ft.Sand Gas Oil Total Depth 4210

PRODUCTION

1st 24 hrs. Nat. 1st 24 hrs. after shot Gas Cu. Ft.Dry Hole Abandoned

Date

DEC 23 1941 19

S. J. LEWIS Scout