

Map No. 15 Sec. 2 Twp. 25 R. 6

Well No. 1 Makr- Farm

Star Jennings Ebal Company

NORTH

WEST

EAST

SOUTH

Location _____

Drilling Remarks:

Rig up _____

Drilling Remarks:

RECORD

Cased _____ in. _____ ft.

Sand

Gas

Oil _____

Total Depth _____

PRODUCTION

1st 24 hrs Nat. _____

1st 24 hrs. after shot_____

Gas _____ cu. ft.

Dry Hole _____

Abandoned _____

Map No. X Sec. 2 Twp. 25 R. 6 W

Well No. 1-Mohr Farm


Star Jennings et al Company

Ft. from N. Line

200 Ft. from S. Line

Ft. from E. Line

1120 Ft. from W. Line

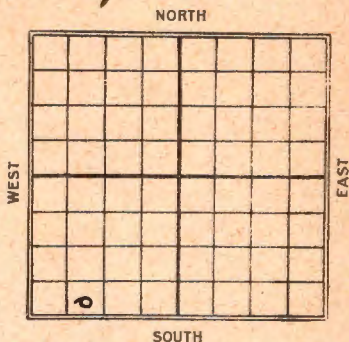

Beneas

Date

REPORT

6/10 Location

11/22 S.D. 3579 Small Sho 3549'

1925 ————

1/21 ————

1925
6/2 D+A 3579
Will Complete

Map No. **KANSAS** Sec. **2** Twp. **25** R. **6W**
 Well No. **#1** **Mahr**
Star Jennings et al Company
 Contractor

FIRST REPORT

SECTION PLAT

_____ Ft. from N. Line
200 Ft. from S. Line
 _____ Ft. from E. Line
1120 Ft. from W. Line

0			

Location **1**
 Rig up _____
 Drilling and Remarks:

RECORD

Cased _____ in., _____ ft.
 Sand _____
 Gas _____
 Oil _____
 Total Depth _____

PRODUCTION

1st 24 hrs. Nat. _____
 1st 24 hrs. after shot _____
 Gas _____ Cu. Ft.
 Dry Hole _____
 Abandoned _____

Date **JUN 10 1924**

M. A. BENEAR

Map No. 14 Sec. 2 Twp. 25 R. 6WWell No. 1 MahoStar Drilling Company

Contractor

ABANDONED

SECTION PLAT

-----Ft. from N. Line

200 Ft. from S. Line

-----Ft. from E. Line

1120 Ft. from W. Line

Location -----

Rig up -----

Drilling and Remarks:

L2493579'

RECORD

Cased ----- in., ----- ft.

Sand -----

Gas -----

Oil -----

Total Depth -----

PRODUCTION

1st 24 hrs. Nat. -----

1st 24 hrs. after shot -----

Gas ----- Cu. Ft.

Dry Hole -----

Abandoned -----

Date

6/9 1925 Scout

MAP NO. _____ SEC. 2 TWP. 25S R. 6WWELL NO. 1 MohrJennings Pells et al COMPANY

CONTRACTOR

SECTION PLAT

_____ FT. FROM N. LINE

_____ FT. FROM S. LINE

_____ FT. FROM E. LINE

_____ FT. FROM W. LINE

OK

LOCATION _____

RIG UP _____

DRILLING AND REMARKS:

Don't check
likes feel
but we
show 357.9
not changing

RECORD

CASED _____ IN. _____ FT.

SAND _____

GAS _____

OIL _____

TOTAL DEPTH 357.9

PRODUCTION

1ST 24 HRS. NAT. _____

1ST 24 HRS. AFTER SHOT _____

GAS _____ CU. FT.

DRY HOLE ✓

ABANDONED _____

DATE

11/15 1924

SCOUT