

Reno

KANSAS

SECTION 23 TOWNSHIP 25 RANGE 7W

WELL NO. #1 Clayton

COMPANY Harold Mottwitz etal

NORTH

							0

WEST

EAST

SOUTH

Reno

KANSAS

SEC.	TWP.	R.
23	25	7W

WELL NO.

#1 Clayton

FARM

COMPANY

Harold Kottwitz etal

CONTRACTOR

Welch & Olsson

WILDCAT


_____ Ft. from N. Line

_____ Ft. from S. Line

_____ Ft. from E. Line

_____ Ft. from W. Line

NE NE SE

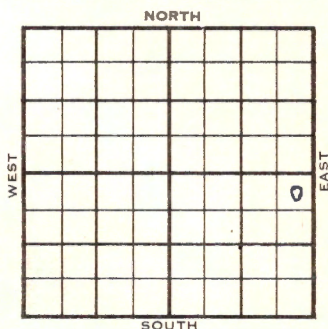

1956	ELEVATION 1488 DF, 1490 RB REPORT
------	--------------------------------------

3-28 Comm. 3-26-56
8" @ 265 w/200
WOC

4-18 D & A
H. 2790
Tr. 2807
BL. 2992
L. 3022
Marm 3379
Ce. 3586
M. 3705
K. 3842
Mz. 4046
V. 4054
S. sh. 4070
S. sd. 4086
A. 4159
TD 4175'

ABANDONED

1488 DF

1490 RB

County

Reno

Elev.

Sec.

23

Twp.

25

Rge.

7W

Company

Harold Kottwitz et al.

Farm Name

Clayton

No.

1

TOPS

DEPTH

LOG

DATUM

Loc. in Sec.

Anh.

NE NE SE

Tp.

H.

Tr.

Dg.

Bl.

L.

K.C.

B.K.C.

Ce.

C.

M.

M.

K.

Mz.

Mq.

V.

S.

S.

A.

R.

Pc.

G.

T.D.

2790

2807

2992

3022

1534

3379

1891

3586

2098

3725

2217

3842

2354

4046

2558

4054

2566

4070

2582

4086

2598

4159

2671

4175

Geol.

Contr.

Welch & Olsson

Pool

Wildcat

ABANDONED

0

Date Comm.

3-26-56

APR 18 1956

8" @ 265/200

D & A

County Reno Elev. _____ Co. _____
 Sec. 23 Twp. 25 Rge. 7W
 Company Harold Kottwitz et al.
 Farm Name Clayton No. 1

TOPS	DEPTH	LOG	DATUM	Loc. in Sec.
Anh.				NE NE SE
TP.				
H.				
Tr.				
Dg.				
Bl.				
L.				Geol.
K.C.				Contr.
B.K.C.				Welch & Olsson
Ce.				Pool
C.				Wildcat
M.				
M.				
K.				
Mz.				
Me.				
V.				
S.				FIRST REPORT
S.				MAR 28 '56
A.				
R.				
Pe.				
G.				
T.D.				

Date Comm. 3-26-56
8" @ 265/200 WOC

27