

Sec. 33 Twp. 25 R. 8-W

Well No. #1 Frazee Farm

Shell Company


(Wildcat)

 Ft. from N. Line

990 Ft. from S. Line

330 Ft. from E. Line

 Ft. from W. Line

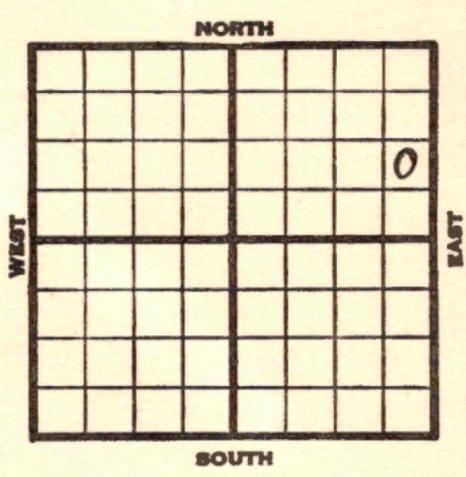

Elev. 1567

1940	REPORT
1/24	Pits.
2/1	8" - 357' Drlg. 1365'
2/8	Ft. Riley 1425' Neva 1860'
	Drlg. 2704'
2/15	Topeka 2653' Lans. 3220'
	S.O. 3513' Drlg. 3551'
2/23	Miss. 3803' Drlg. 4003'
2/28	Arb. 4240'
	T.D. 4280'
	Water.
	ABANDONED

Map No. 41 Sec. 33 Twp. 25 R. 8W

Well No. 1 Frazee

Shell Company

Contractor

SECTION PLAT

NE SE NE

_____ Ft. from N. Line

990 Ft. from S. Line

330 Ft. from E. Line

_____ Ft. from W. Line

			o

WILDCAT

Location _____

Rig up _____

Drilling and Remarks:

Pits

RECORD

Cased _____ in., _____ ft.

Sand _____

Gas _____

Oil _____

Total Depth _____

PRODUCTION

1st 24 hrs. Nat. _____

1st 24 hrs. after shot _____

Gas _____ Cu. Ft.

Dry Hole _____

Abandoned _____

Date

JAN 2 ± 1940

19

S. J. LEWIS

Scout

