

KANSAS


Reno

FORM 51 5M 1-42 PETROL

Section 12 Township 25 Range 8-W

Well No. #1 Witt

Company Lauck & Moncrief

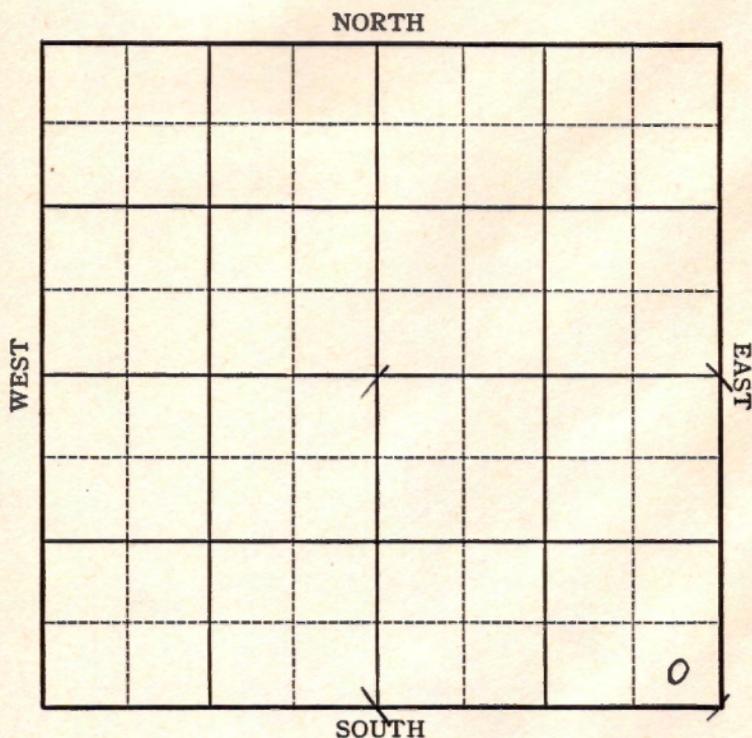

KANSAS

Reno

Sec. 12 Twp. 25 R. 8-W

Well No. #1 Witt Farm

Lauck & Moncrief Company

Wildcat


_____ Ft. from N. Line

330 Ft. from S. Line

330 Ft. from E. Line

_____ Ft. from W. Line

Elev. 1601

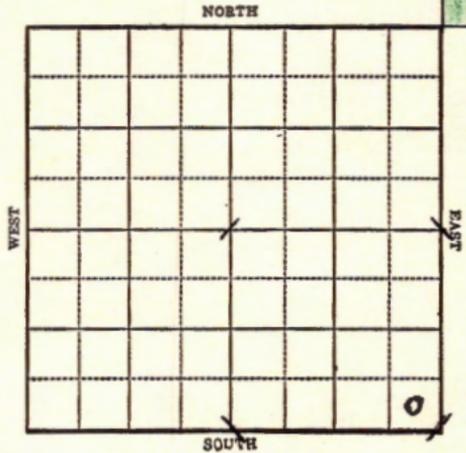

1943

R E P O R T

- 4/28 Rotary
- 5/5 "
- 5/12 10" @ 185' WOC
- 5/19 Drlg. 2040'
- 5/26 **Lans. 3210**
Drlg. 3404'
- 6/2 **Miss. 3802**
Drlg. 3955'
- 6/9 **Arb. 4264**
T.D. 4290'
No shows.

ABANDONED

KANSAS

Reno

Map No. 41 Sec. 12 Twp. 25 R. 8W

Well No. 1 Witt

Lauck & Moncrief Company

FIRST REPORT Contractor

SE/C


SECTION PLAT

_____ Ft. from N. Line

330 Ft. from S. Line

330 Ft. from E. Line

_____ Ft. from W. Line

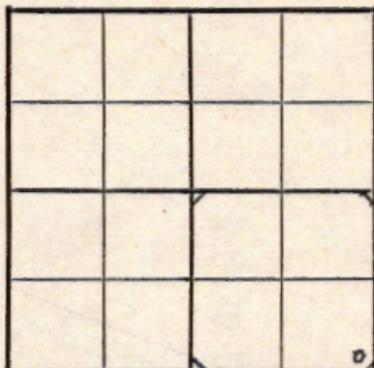

WILDCAT

Location _____

Rig up _____

Drilling and Remarks:

Rotary

RECORD

Cased _____ in., _____ ft.

Sand _____

Gas _____

Oil _____

Total Depth _____

PRODUCTION

1st 24 hrs. Nat. _____

1st 24 hrs. after shot _____

Gas _____ Cu. Ft.

Dry Hole _____

Abandoned _____

Date

APR 28 1943 19

S. J. LEWIS Scout

KANSAS

Reno

Map No. 41 Sec. 12 Twp. 25 R. 8WWell No. 1 WittLauck & Moncrief CompanyABANDONED Contractor

SE/C

SECTION PLAT

_____ Ft. from N. Line

330 Ft. from S. Line330 Ft. from E. Line

_____ Ft. from W. Line

WILDCAT

Location _____

Rig up _____

Drilling and Remarks:

*Cr 4264**No show*

RECORD

Cased _____ in., _____ ft.

Sand _____

Gas _____

Oil _____

Total Depth 4290

PRODUCTION

1st 24 hrs. Nat. _____

1st 24 hrs. after shot _____

Gas _____ Cu: Ft. _____

Dry Hole _____

Abandoned _____

Date

JUN 9 1943 19S. J. LEWIS Scout