

Sedgwick

Map No. **KANSAS** Sec. 1 Twp. 26 R. 1^W

Well No. 1 - Sam Brought Farm


Prairie-Slick Company

330 Ft. from N. Line

_____ Ft. from S. Line

_____ Ft. from E. Line

990 Ft. from W. Line

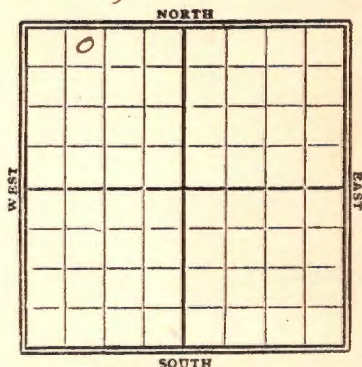

1929

Date REPORT

Date	REPORT
7/10	Rig
7/17	PT
7/24	Rig up.
7/31	Spdy
8/7	Wrlly 782'
8/14	" 1170
8/21	- 1500'
8/28	log took 1950
9/4	Wrlly 2470
9/11	" 2680
9/18	8" U.R. - 2825
9/25	Wrlly 2900'
10/2	Top chat 3055'
	8" - 3080' Plog out
10/9	Wrlly 3100'
10/16	Chat 3060-80
	T.D. 3250-Run 6"
10/23	Sand 3364-69
	T.D. 3369
	swabs 274 bbl oil
	Sump

Georgewick
Form 26 - 4M Bks. - 2-23

KANSAS

Map No. 39 Sec. 1 Twp. 26 R. 1 W

Well No. Sam Bugh

Prairie - Oil & Gas Company

Contractor

SECTION PLAT

330 Ft. from N. Line

_____ Ft. from S. Line

_____ Ft. from E. Line

990 Ft. from W. Line

0			

FIRST REPORTS

Location _____

Rig up _____

Drilling and Remarks:

Rig

RECORD

Cased _____ in., _____ ft.

Sand _____

Gas _____

Oil _____

Total Depth _____

PRODUCTION

1st 24 hrs. Nat. _____

1st 24 hrs. after shot _____

Gas _____ Cu. Ft.

Dry Hole _____

Abandoned _____

Date

JUL 10 1929 19

S. J. LEWIS

Scout

Map No. **KANSAS** Sec. 1 Twp. 26 R. 14

Well No. 1 Sam Bright

Prairie - Oil & Gas Company

Contractor

SECTION PLAT

0			

220 Ft. from N. Line

..... Ft. from S. Line

..... Ft. from E. Line

990 Ft. from W. Line

COMPLETED

Location.....

Rig up.....

Drilling and Remarks:

Swath 274 yds

RECORD

Cased..... in., ft.

Sand 2264-69

Gas.....

Oil.....

Total Depth 2269

PRODUCTION

1st 24 hrs. Nat.....

1st 24 hrs. after shot.....

Gas..... Cu. Ft.

Dry Hole.....

Abandoned.....

Date

OCT 23 1929

192

S. J. LEWIS

Scout