

*Sedgwick*

Map No. **KANSAS** Sec. *1* Twp. *26* R. *1W*

Well No. *2-S. Bright* Farm  
*Kentz Oil & Corp.* Company

NORTH

WEST

EAST

			0				

SOUTH

Location.....

Rig Up.....

Drilling Remarks

Drilling Remarks

.....

.....

RECORD

PRODUCTION

Cased..... in..... ft.

1st 24 hrs. Nat.....

Sand.....

1st 24 hrs. after shot.....

Gas.....

Gas..... cu. ft.....

Oil.....


Dry Hole.....

Total Depth.....

Abandoned.....

Map No. **KANSAS** Sec. *1* Twp. *26* R. *1<sup>w</sup>*  
Well No. *2 - S. Bright* Farm  
*Henty Oil Corp.* Company

..... Ft. from N. Line  
*330* Ft. from S. Line  
*330* Ft. from E. Line  
..... Ft. from W. Line

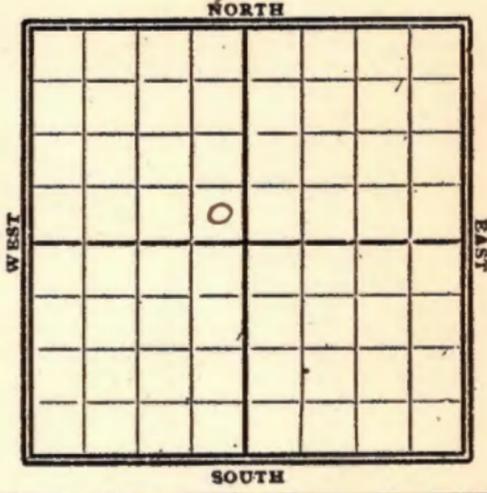

*1929*

Date	REPORT
<i>6/12</i>	<i>Location</i>
<i>6/19</i>	<i>Bldg Rig</i>
<i>6/26</i>	<i>Rign up</i>
<i>7/2</i>	<i>Rign up</i>
<i>7/10</i>	<i>Drly 1365'</i>
<i>7/17</i>	<i>50' 1365 hgh water</i>
<i>7/24</i>	<i>Drly 2165'</i>
<i>7/31</i>	<i>" 2500'</i>
<i>8/7</i>	<i>" 2740'</i>
<i>8/14</i>	<i>" 2910'</i>
<i>8/21</i>	<i>Top. Mas &amp; 3013 Drly 3210'</i>
<i>8/28</i>	<i>Base miss line 3246 sand 3336-37 filled up 2000' in 30 min</i>
<i>9/4</i>	<i>1<sup>st</sup> pay 3336-37 2<sup>nd</sup> pay 3360-65' + T.D. 3365' swab 720 bbl oil Comp.</i>

Map No. **KANSAS** Sec. 1 Twp. 26 R. 1W

Well No. 2 S. Bright

Montg Oil Corp Company

Contractor

**SECTION PLAT**

..... Ft. from N. Line  
880 Ft. from S. Line  
320 Ft. from E. Line  
 ..... Ft. from W. Line

	0		

**FIRST REPORTS**

Location

Rig up .....

Drilling and Remarks:

**RECORD**

Cased..... in., ..... ft.

Sand.....

Gas.....

Oil.....

Total Depth.....

**PRODUCTION**

1st 24 hrs. Nat.....

1st 24 hrs. after shot.....

Gas..... Cu. Ft.

Dry Hole.....

Abandoned.....

Date

**JUN 12 1929**

**S. J. LEWIS** Scout

Map No. *39* **KANSAS** Sec. *1* Twp. *26* R. *1W*

Well No. *2 S Bright*

*Newtz Oil Corp.* Company

Contractor

SECTION PLAT

.....Ft. from N. Line

*330* Ft. from S. Line

*330* Ft. from E. Line

.....Ft. from W. Line


**COMPLETED**

Location.....

Rig up.....

Drilling and Remarks:

*1st Pay 3386-37*

*2nd Pay 3360-65*

*Sum 78720886*

RECORD

Cased.....in., .....ft.

Sand.....

Gas.....

Oil.....

Total Depth *3365*

PRODUCTION

1st 24 hrs. Nat.....

1st 24 hrs. after shot.....

Gas.....Cu. Ft.

Dry Hole.....

Abandoned.....

Date

**SEP 4 1929**

192

**S. J. LEWIS** Scout