


Sedgwick
Form 51-5M-2-29-34703

Map No. **KANSAS** Sec. *1* Twp. *26* R. *1W*
Well No. *1-A* *Bright* Farm
Kentz Oil & Dev Company

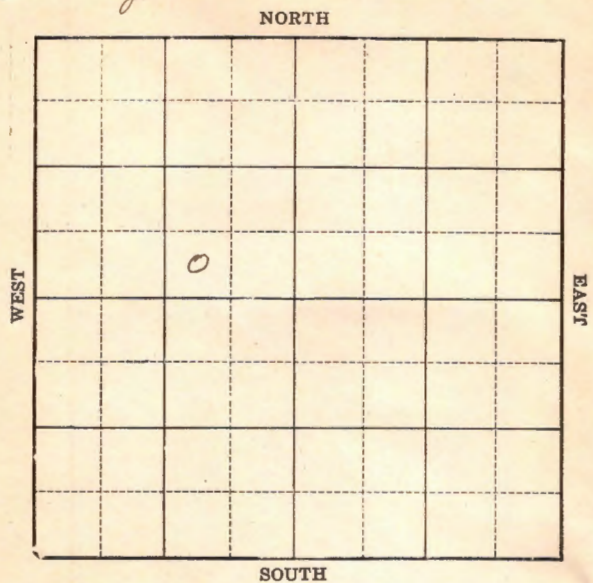

Location _____
Drilling Remarks _____

Rig Up _____
Drilling Remarks _____

RECORD

Cased _____ in. _____ ft.
Sand _____
Gas _____
Oil _____
Total Depth _____

PRODUCTION

1st 24 hrs. Nat. _____
1st 24 hrs. after shot _____
Gas _____ cu. ft. _____
Dry Hole _____
Abandoned _____

Sedgwick
 Map No. **KANSAS** Sec. *1* Twp. *26* R. *1W*
 Well No. *1-17* *Bright* Farm
Wentz Oil Div Company

NORTH

_____ Ft. from N. Line


330 Ft. from S. Line

940 Ft. from E. Line

_____ Ft. from W. Line

WEST

EAST

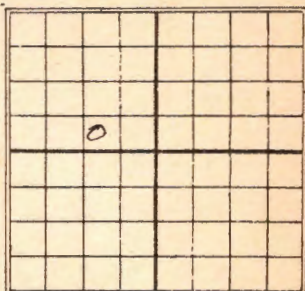

SOUTH

Date

REPORT

Form #4
Kans. City lime test

6/11

Loc

6/18

Relay 2692'
1/2 bails oil per
hour

6/25

7/2

Kansas City lime 2574
Base KC lime 2692
TD 2692
Crump 105 bbl oil
Comp.

Map No. **KANSAS** Sec. 1 Twp. 26 R. W

Well No. 1-A Bright

Company Wentz Oil Co.

Contractor _____

SECTION PLAT

_____ Ft. from N. Line

320 Ft. from S. Line

940 Ft. from E. Line

_____ Ft. from W. Line

FIRST REPORTS

Location _____

Rig up _____

Drilling and Remarks:

*Kansas City lime
test.
John D. A. H.*

RECORD

Cased _____ in., _____ ft.

Sand _____

Gas _____

Oil _____

Total Depth _____

PRODUCTION

1st 24 hrs. Nat. _____

1st 24 hrs. after shot _____

Gas _____ Cu. Ft.

Dry Hole _____

Abandoned _____

Date

JUN 11 1930

S. J. LEWIS Scout

Map No. **KANSAS** Sec. 1 Twp. 26 R. 14

Well No. 1 A Bright

Wentz Oil & Gas Company

Contractor

SECTION PLAT

 Ft. from N. Line

330 Ft. from S. Line

940 Ft. from E. Line

 Ft. from W. Line

COMPLETED

Location

Rig up

Drilling and Remarks:

KC Linc 2574-
2692

Pump 1058 ft.

RECORD

Cased in., ft.

Sand

Gas

Oil

Total Depth 2692

PRODUCTION

1st 24 hrs. Nat.

1st 24 hrs. after shot

Gas Cu. Ft

Dry Hole

Abandoned

Date

JUL 2 1930

S. J. LEWIS Seco