

WEST

EAST


SOUTH

Drilling Remarks

Abandoned _____

Map No. **KANSAS** Sec. 1 Twp. 26 R. 1^W
 Well No. 5 - Red Farm Bu-Vi-Bar et al Company

 Ft. from N. Line
330 Ft. from S. Line
 Ft. from E. Line
940 Ft. from W. Line

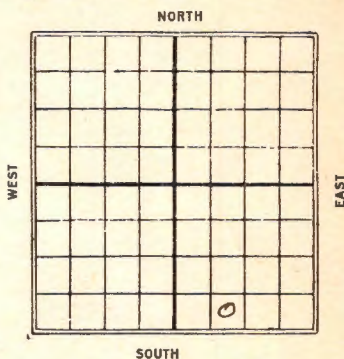

1929

Date	REPORT
9/25	Bldg Rig
9/25	
10/2	Drly 535'
10/9	" 1340'
10/16	" 2005'
10/23	" 2590'
10/30	" 2995'
11/6	" 3210'
11/13	Wlg 3348 Baseline 3260
11/20	Sand 3355-59'
	T.D. 3359'
	swab 592 bbls oil
	Comp.

Map No. KANSAS Sec. 1 Twp. 26 R. 1 W

Well No. 5 Reel

Bu Vi Bar & Co Company

Contractor

SECTION PLAT

Ft. from N. Line

330 Ft. from S. Line

Ft. from E. Line

990 Ft. from W. Line

FIRST REPORTS

Location

Rig up

Drilling and Remarks:

Building rig

RECORD

Cased in, ft.

Sand

Gas

Oil

Total Depth

PRODUCTION

1st 24 hrs. Nat.

1st 24 hrs. after shot

Gas Cu. Ft.

Dry Hole

Abandoned

Date

SEP 25 1929

192

S. J. LEWIS Scout

Map No. 39 **KANSAS** Sec. 1 Twp. 26 R. 1W

Well No. 5 Reel

Bu Vi Bar & Oil Company

Contractor

SECTION PLAT

Ft. from N. Line

330 Ft. from S. Line

Ft. from E. Line

990 Ft. from W. Line

COMPLETED

Location

Rig up

Drilling and Remarks:

Sw 88 592886

RECORD

Cased _____ in., _____ ft.

Sand 335559

Gas _____

Oil _____

Total Depth 3359

PRODUCTION

1st 24 hrs. Nat. _____

1st 24 hrs. after shot _____

Gas _____ Cu. Ft.

Dry Hole _____

Abandoned _____

Date

NOV 20 1920

S. J. LEWIS Scout