


Map No. KANSAS Sec. 1 Twp. 26 R. 1^W

Well No. 6-Red Farm Bu-Vi-Barital Company

NORTH

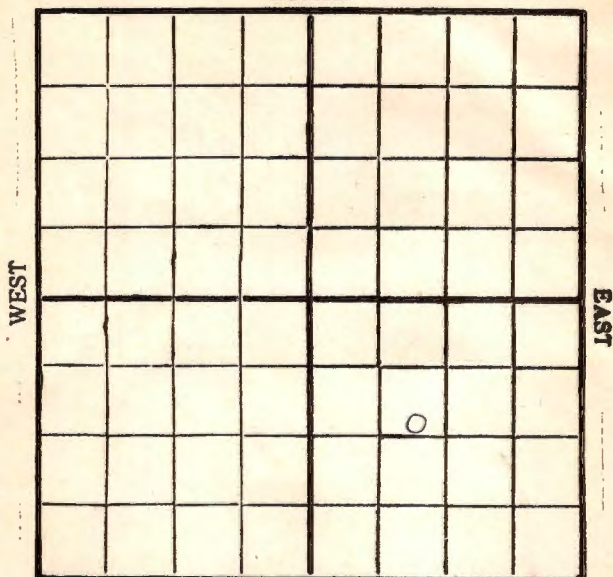

SOUTH

Location _____

Drilling Remarks _____

Rig Up _____

Drilling Remarks _____

RECORD

Cased _____ in. _____ ft.

Sand _____

Gas _____

Oil _____

Total Depth _____

PRODUCTION

1st 24 hrs. Nat. _____

1st 24 hrs. after shot _____

Gas _____ cu. ft. _____

Dry Hole _____

Abandoned _____

Map No. **KANSAS** Sec. 1 Twp. 26 R. 1W


Well No. 6- Ried Farm
Bu-Vi-Bar et al Company

 Ft. from N. Line

1350 Ft. from S. Line

1500 Ft. from E. Line

 Ft. from W. Line

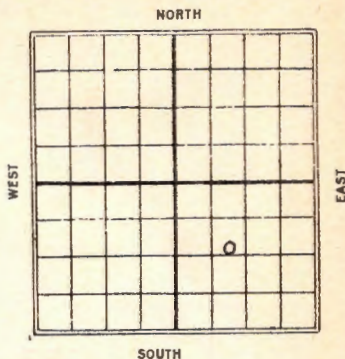

1929

Date

REPORT

10/9	RUR
10/16	229730
10/23	" 2220'
10/30	" 2980'
11/6	" 3340'
11/13	Timpson 3356-59'
	T.D. 3359'
	Swab 1594 bbls oil
	Comp.

Oedgewick

Map No. **KANSAS** Sec. 1 Twp. 26 R. 14Well No. 6 P SeelyBu Vi Bar & Co. Company

Contractor

SECTION PLAT

Ft. from N. Line

1350 Ft. from S. Line1500 Ft. from E. Line

Ft. from W. Line

		0	

FIRST REPORTS

Location

Rig up

Drilling and Remarks:

*Rigging up
Rotary*

RECORD

Cased in., ft.

Sand

Gas

Oil

Total Depth

PRODUCTION

1st 24 hrs. Nat.

1st 24 hrs. after shot

Gas Cu. Ft.

Dry Hole

Abandoned

Date

OCT 9 1929

192

S. J. LEWIS Scout

Map No. **KANSAS** Sec. 1 Twp. 26 R. 1W

Well No. 6 Reed

Burke Bar et al. Company

Contractor

SECTION PLAT

.....Ft. from N. Line

1250 Ft. from S. Line

1500 Ft. from E. Line

.....Ft. from W. Line

COMPLETED

Location.....

Rig up.....

Drilling and Remarks:

Sample 8856-59

Swath 1594 yds

RECORD

Cased 1 in.,ft.

Sand.....

Gas.....

Oil.....

Total Depth 8859

PRODUCTION

1st 24 hrs. Nat.....

1st 24 hrs. after shot.....

Gas.....Cu. Ft.

Dry Hole.....

Abandoned.....

Date

NOV 13 1929

192.....

S. J. LEWIS

Scout