


Sedgwick

Map No. **KANSAS** Sec. 1 Twp. 26 R. 1^w

Well No. 7-Red Farm

Continental & Gypsy Company

NORTH

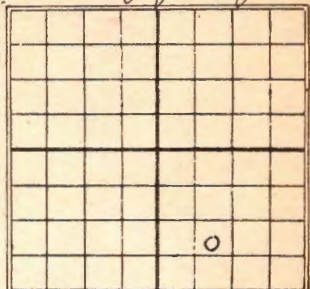

_____ Ft. from N. Line

810 Ft. from S. Line

_____ Ft. from E. Line

990 Ft. from W. Line

1930

Date

REPORT

1/8	Bldg Rig
1/15	Tr
1/22	Spud
1/29	HFW at 965'
	dry 1050'
2/5	" 1790
2/12	" 2530'
2/19	2715 U.P. 8"
2/26	Drilg. 3125.
3/5	" 3080 HFW
	3070'
3/12	Land 3270-72'
	T.D. 3272
	swab 682 bbl oil
	Sump

Seelyweck

Map No. KANSAS Sec. 1 Twp. 26 R. 1W

Well No. 7 Reed

Continental & Gypsum Company
Contractor

SECTION PLAT

		o	

_____ Ft. from N. Line

870 Ft. from S. Line

_____ Ft. from E. Line

990 Ft. from W. Line

FIRST REPORTS

Location _____

Rig up _____

Drilling and Remarks:

Building rig

RECORD

Cased _____ in., _____ ft.

Sand _____

Gas _____

Oil _____

Total Depth _____

PRODUCTION

1st 24 hrs. Nat. _____

1st 24 hrs. after shot _____

Gas _____ Cu. Ft.

Dry Hole _____

Abandoned _____

Date

JAN 8 1930

S. J. LEWIS Scout

Map No. *KANSAS* Sec. *1* Twp. *26* R. *1W*

Well No. *2 Reed*

Continental & Gypsum Company
Contractor

SECTION PLAT

..... Ft. from N. Line

810 Ft. from S. Line

..... Ft. from E. Line

990 Ft. from W. Line

COMPLETED

Location.....

Rig up.....

Drilling and Remarks:

Swat 6828 ft

RECORD

Cased..... in., ft.

Sand *3270-72*

Gas.....

Oil.....

Total Depth *3272*

PRODUCTION

1st 24 hrs. Nat.....

1st 24 hrs. after shot.....

Gas..... Cu. Ft.

Dry Hole.....

Abandoned.....

Date

MAR 12 1930

S. J. LEWIS

Scout