

*Stedwich*

Map No. *1* Sec. *26* Twp. *1 W* R. *1 W*

Well No. *2- Wilson* Farm

*Davis & Kelley* Company

NORTH

WEST

EAST

						0	

SOUTH

Location.....

Drilling Remarks

Rig Up.....

Drilling Remarks

.....

.....

RECORD

Cased..... in..... ft.

Sand.....

Gas.....

Oil.....

Total Depth.....

PRODUCTION

1st 24 hrs. Nat.....

1st 24 hrs. after shot.....

Gas..... cu. ft.....

Dry Hole.....

Abandoned.....

Map No. **KANSAS** Sec. 1 Twp. 26 R. 1 W


Well No. 2 - Wilson Farm  
Davis & Skelly Company

962 Ft. from N. Line

\_\_\_\_\_ Ft. from S. Line

990 Ft. from E. Line

\_\_\_\_\_ Ft. from W. Line

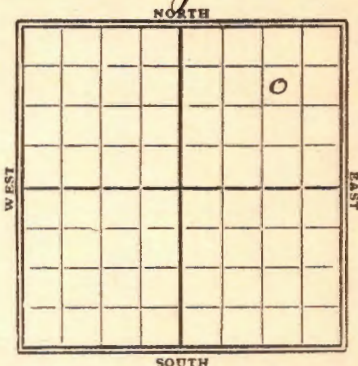

1929

Date	REPORT
1/16	Bldy Rig
1/23	Regr up
1/30	Spud
2/16	drlg 805'
2/13	" 1700'
2/20	" 2095'
2/27	" 2425'
3/6	" 2900'
3/13	Top chat 3035 drlg 3205'
3/18	T.P. 3374' Oil at 3379 T.D. 3385' swab 160 bbls 12 hrs.
3/19	225 bbls.
3/21	240 "
3/20	sand 3374-99' T.D. 3399' Pump 225 bbls Comp.
3/22	255 bbls.
3/23	245 "
3/25	215 " (over)

1929 Production

3/26 - Off

3/28 - 75 bbls 10 hrs. Pump.

4/1 - 172 bbls oil

MAP NO. **KANSAS** SEC. 1 TWP. 26 R. 1W

WELL NO. 2. Wilson

Harris & Skelly Oil COMPANY

CONTRACTOR

**SECTION PLAT**

			0

982 FT. FROM N. LINE

FT. FROM S. LINE

990 FT. FROM E. LINE

FT. FROM W. LINE

**FIRST REPORTS**

LOCATION \_\_\_\_\_

RIG UP \_\_\_\_\_

DRILLING AND REMARKS:

*Rebuilding rig*

**RECORD**

CASED \_\_\_\_\_ IN. \_\_\_\_\_ FT.

SAND \_\_\_\_\_

GAS \_\_\_\_\_

OIL \_\_\_\_\_

TOTAL DEPTH \_\_\_\_\_

**PRODUCTION**

1ST 24 HRS. NAT. \_\_\_\_\_

1ST 24 HRS. AFTER SHOT \_\_\_\_\_

GAS \_\_\_\_\_ CU. FT.

DRY HOLE \_\_\_\_\_

ABANDONED \_\_\_\_\_

DATE

**JAN 16 1929** 192

**S. J. LEWIS**

SCOUT

**KANSAS**

MAP NO. \_\_\_\_\_ SEC. 1 TWP. 26 R. 1W

WELL NO. 2 Wilson

Javis & Kelly Oil COMPANY

CONTRACTOR

**SECTION PLAT**

			0

962 FT. FROM N. LINE

\_\_\_\_\_ FT. FROM S. LINE

990 FT. FROM E. LINE

\_\_\_\_\_ FT. FROM W. LINE

**COMPLETED**

LOCATION \_\_\_\_\_

RIG UP \_\_\_\_\_

DRILLING AND REMARKS:

Band 3374 & 3399  
Pumped 225 & 1/2

**RECORD**

CASED \_\_\_\_\_ IN. \_\_\_\_\_ FT.

SAND \_\_\_\_\_

GAS \_\_\_\_\_

OIL \_\_\_\_\_

TOTAL DEPTH 3899

**PRODUCTION**

1ST 24 HRS. NAT. \_\_\_\_\_

1ST 24 HRS. AFTER SHOT \_\_\_\_\_

GAS \_\_\_\_\_ Cu. Ft.

DRY HOLE \_\_\_\_\_

ABANDONED \_\_\_\_\_

DATE

**MAR 20 1929**

**S. J. LEWIS**

192

SCOUT