

Sedgwick

Form 51-5M-2-29-34703

Map No. **KANSAS** Sec.

Twp.

R.

Well No.

Farm

Company

NORTH

WEST

EAST

SOUTH

Location

Drilling Remarks

Rig Up

Drilling Remarks

RECORD

Cased in. ft.

Sand

Gas

Oil

Total Depth

PRODUCTION

1st 24 hrs. Nat.

1st 24 hrs. after shot

Gas cu. ft.

Dry Hole

Abandoned


Map No. **KANSAS** Sec. 6 Twp. 26 R. 1W
Well No. 7 *Simpson* Farm
Davis & Kelley Company

_____ Ft. from N. Line

330 Ft. from S. Line

990 Ft. from E. Line

_____ Ft. from W. Line

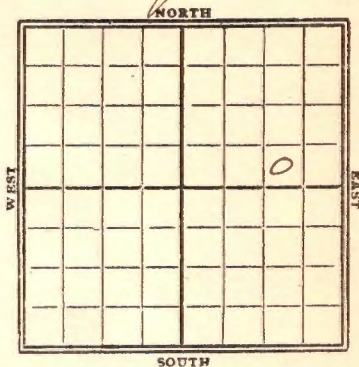

1929

Date

REPORT

4/24 Spud 265'
5/11 perlg 1235'
5/18 T.D. 1930' for bit
5/15 perlg 2850'
5/22 " 3250' - HFW
5/29 Simpson sd 3370-75
T.D. 3375
swab 1375 bbl 24 hr.
Comp.

Map No. KANSAS Sec. 1 Twp. 26 R. 1WWell No. J. H. LewisJ. H. Lewis & S. Kelly Oil Company

Contractor

SECTION PLAT

Ft. from N. Line

830 Ft. from S. Line990 Ft. from E. Line

Ft. from W. Line

			0

FIRST REPORTS

Location

Rig up

Drilling and Remarks:

Spud 265

RECORD

Cased 265 in., 265 ft.

Sand

Gas

Oil

Total Depth

PRODUCTION

1st 24 hrs. Nat.

1st 24 hrs. after shot

Gas 265 Cu. Ft.

Dry Hole

Abandoned

Date

APR 24 1929192S. J. LEWIS

Scout

Map No. **KANSAS** Sec. 1 Twp. 26 R. 1 WWell No. 7 SkiltonLewis & Skelly Oil Company

Contractor

SECTION PLAT

Ft. from N. Line

330 Ft. from S. Line990 Ft. from E. Line

Ft. from W. Line

COMPLETED

			0

Location.....

Rig up.....

Drilling and Remarks:

Superior Sand
3870-75Swatford
1375 x 124 hrs

RECORD

Cased.....in.,ft.

Sand.....

Gas.....

Oil.....

Total Depth 3875

PRODUCTION

1st 24 hrs. Nat.....

1st 24 hrs. after shot.....

Gas.....Cu. Ft.

Dry Hole.....

Abandoned.....

Date

MAY 29 1920**S. J. LEWIS** Scout