

Sedgwick
Form 51-5M-229-34703

Map No. **KANSAS** Sec.

Twp. 26 R. 1W

Well No. 8-

Farm

Company
Davis & Kelly

NORTH

WEST

EAST

SOUTH

Location

Drilling Remarks

Rig Up

Drilling Remarks

RECORD

Cased in. ft.

Sand

Gas

Oil

Total Depth

PRODUCTION

1st 24 hrs. Nat.

1st 24 hrs. after shot

Gas cu. ft.

Dry Hole

Abandoned


Sedgwick
 Map No. **KANSAS** Sec. *1* Twp. *26* R. *1^W*
 Well No. *S. Wilson* Farm
Lavis & Skelly Company

Ft. from N. Line

330 Ft. from S. Line

Ft. from E. Line

990 Ft. from W. Line

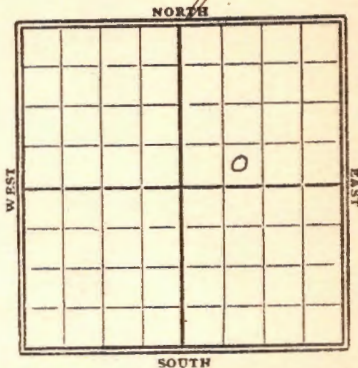

Date

REPORT

Date	REPORT
<i>4/24</i>	<i>Location</i>
<i>5/1</i>	<i>Spud</i>
<i>5/8</i>	<i>Merlg 1050</i>
<i>5/15</i>	<i>" 1890'</i>
<i>5/22</i>	<i>" 2450'</i>
<i>5/29</i>	<i>" 2980'</i>
<i>6/5</i>	<i>" 3235'</i>
	<i>Base miss line 3230</i>
<i>6/12</i>	<i>Simpson 3367-72 1/2'</i>
	<i>T.D. 3372 1/2'</i>
	<i>swab 1200 bbls</i>
	<i>Sorp.</i>

Map No. KANSAS Sec. 1 Twp. 26 R. 1WWell No. 5 WilsonLewis & Kelly Oil Company

Contractor

SECTION PLAT

Ft. from N. Line

330 Ft. from S. Line

Ft. from E. Line

990 Ft. from W. Line

		0	

FIRST REPORTS

Location ✓

Rig up

Drilling and Remarks:

RECORD

Cased.....in.,ft.

Sand

Gas

Oil

Total Depth

PRODUCTION

1st 24 hrs. Nat.

1st 24 hrs. after shot

Gas.....Cu. Ft.

Dry Hole

Abandoned

Date

APR 24 1929

192

S. J. LEWIS

Scout

Sedgwick
 Map No. **KANSAS** Sec. *1* Twp. *26* R. *1W*

Well No. *J. Wilson*

James & Skelly Oil Company

Contractor


SECTION PLAT

..... Ft. from N. Line

330 Ft. from S. Line

..... Ft. from E. Line

790 Ft. from W. Line

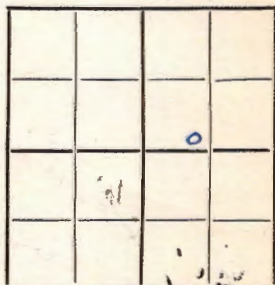

COMPLETED

Location.....

Rig up.....

Drilling and Remarks:

Superior 8367

& 8372 1/2

Swath 1200 ft

RECORD

Cased.....in.,ft.

Sand.....

Gas.....

Oil.....

Total Depth.....*3372 1/2*

PRODUCTION

1st 24 hrs. Nat.....

1st 24 hrs. after shot.....

Gas.....Cu. Ft.

Dry Hole.....

Abandoned.....

Date

JUN 12 1929

192.....

S. J. LEWIS Scout