

Map No. **KANSAS** Sec. 1 Twp. 26 R. 1 W

Well No. 12- Wilson Farm
Davis & Kelly Oil Company

NORTH

						0	

WEST

EAST

SOUTH

Location.....

Drilling Remarks.....

.....

.....

Rig Up.....

Drilling Remarks.....

.....

.....

RECORD

Cased..... in..... ft.

Sand.....

Gas.....

Oil.....

Total Depth.....

PRODUCTION

1st 24 hrs. Nat.....

1st 24 hrs. after shot.....

Gas..... cu. ft.....


Dry Hole.....

Abandoned.....

Map No. **KANSAS** Sec. 1 Twp. 26 R. 1^w

Well No. 12- Wilson Farm
Davis & Kelley Oil Company

..... Ft. from N. Line
990 Ft. from S. Line
990 Ft. from E. Line
..... Ft. from W. Line

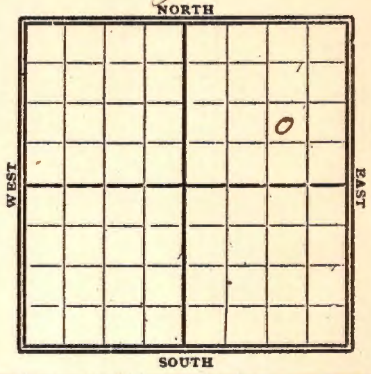

1929

Date	REPORT
6/26	Location
7/2	A
7/10	Spud 90'
7/17	Drly 995'
7/24	" 1865'
7/31	" 2418'
8/7	" 3005'
8/14	" 3270
8/21	camp.
8/21	sand 3379-81'
	TD 3385'
	124 bbl oil
	165 " water
	Pump

Map No. **KANSAS** Sec. 1 Twp. 26 R. 1W

Well No. 12 Nelson

Davis & Skelley Oil Company

Contractor

SECTION PLAT

			o

.....Ft. from N. Line

990 Ft. from S. Line

990 Ft. from E. Line

.....Ft. from W. Line

FIRST REPORTS

Location.....

Rig up.....

Drilling and Remarks:

RECORD

Cased.....in.,ft.

Sand.....

Gas.....

Oil.....

Total Depth.....

PRODUCTION

1st 24 hrs. Nat.....

1st 24 hrs. after shot.....

Gas.....Cu. Ft.

Dry Hole.....

Abandoned.....

Date

JUN 26 1929

192

S. J. LEWIS

Scout

Map No. KANSAS Sec. 1 Twp. 26 R. 1W

Well No. 12. Wilson

Tavis & Skelly Oil Company

Contractor

SECTION PLAT

..... Ft. from N. Line

990 Ft. from S. Line

990 Ft. from E. Line

..... Ft. from W. Line

			0

COMPLETED

Location.....

Rig up.....

Drilling and Remarks:

124 x 8 1/2 in
165 " water

RECORD

Cased..... in., ft.

Sand 3279-81

Gas.....

Oil.....

Total Depth 3285

PRODUCTION

1st 24 hrs. Nat.....

1st 24 hrs. after shot.....

Gas..... Cu. Ft.

Dry Hole.....

Abandoned.....

Date

AUG 2 1 1929

S. J. LEWIS Scout

Seeghick

39

KANSAS

Map No. _____ Sec. 1 Twp. 26 R. 1 ^W

Well No. 12 *Wilson*

Davis. Kelly, et al Company

Contractor

SECTION PLAT

			0

_____ Ft. from N. Line

990 Ft. from S. Line

990 Ft. from E. Line

_____ Ft. from W. Line

ABANDONED

Location _____

Rig up _____

Drilling and Remarks:

Plugged

9/14/31

RECORD

Cased _____ in., _____ ft.

Sand _____

Gas _____

Oil _____

Total Depth 3385

PRODUCTION

1st 24 hrs. Nat. _____

1st 24 hrs. after shot _____

Gas _____ Cu. Ft.

Dry Hole _____

Abandoned _____

Date

JAN 30 1932

19

CHAS. L. SHERWOOD

Scout