

Map No. **KANSAS** Sec. 12 Twp. 26 R. 1

Well No. 13-16 Wilson Farm

NORTH 1



EAST

SOUTH

Location _____

Drilling Remarks

Rig Up _____

Drilling Remarks

RECORD

Cased _____ in. _____ ft.

Sand _____

Gas _____

Oil _____

Total Depth_____

PRODUCTION

1st 24 hrs. Nat. _____

1st 24 hrs. after shot_____

Gas_____cu. ft._____

Dry Hole_____

Abandoned _____


Sidgwick
 Map No. **KANSAS** Sec. *1* Twp. *26* R. *1^W*
 Well No. *13* *Wilson* Farm
Havis - Kelly Oil et al Company

_____ Ft. from N. Line

990 Ft. from S. Line

_____ Ft. from E. Line

990 Ft. from W. Line

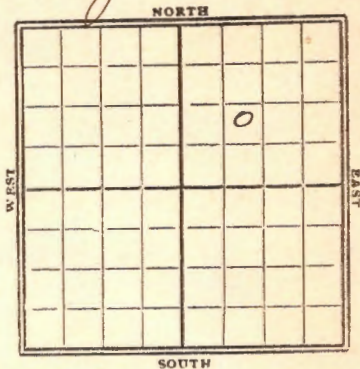

1929

Date

REPORT

<i>8/7</i>	<i>Rig</i>
<i>8/14</i>	<i>bleed 610'</i>
<i>8/21</i>	<i>reg 1840</i>
<i>8/28</i>	<i>" 2650'</i>
<i>9/4</i>	<i>" 3012</i>
<i>9/11</i>	<i>sand 3374'-79 1/2'</i>
	<i>TD. 3379 1/2'</i>
	<i>swab 275 bbl oil</i>
	<i>Comp.</i>

Stedwick
 39 **KANSAS** Map No. _____ Sec. 1 Twp. 26 R. 1 *W*

Well No. 13 *Wilson*
Davis - Skelly & Co Company

Contractor

FIRST REPORTS

SECTION PLAT

		0	

_____ Ft. from N. Line

990 Ft. from S. Line

_____ Ft. from E. Line

990 Ft. from W. Line

Location _____

Rig up ☒

Drilling and Remarks:

RECORD

Cased _____ in., _____ ft.

Sand _____

Gas _____

Oil _____

Total Depth _____

PRODUCTION

1st 24 hrs. Nat. _____

1st 24 hrs. after shot _____

Gas _____ Cu. Ft.

Dry Hole _____

Abandoned _____

Date

AUG 7 1929

CHAS. L. SHERWOOD

19

Scout

Map No. **KANSAS** Sec. 1 Twp. 26 R. 1W

Well No. 13 Wilson

Davis-Speilly Oil Company

Contractor

SECTION PLAT

Ft. from N. Line

990 Ft. from S. Line

Ft. from E. Line

990 Ft. from W. Line

		0	

COMPLETED

Location

Rig up

Drilling and Remarks:

Swath 275 Hrs

RECORD

Cased in., ft.

Sand 3374-79 1/2

Gas

Oil

Total Depth 3379 1/2

PRODUCTION

1st 24 hrs. Nat.

1st 24 hrs. after shot

Gas Cu. Ft.

Dry Hole

Abandoned

Date

SEP 11 1929

192

S. J. LEWIS

Scout

39 **KANSAS** Map No. _____ Sec. 1 Twp. 26 R. 1 ^W

Well No. 13 Wilson
Davis. Kelly et al Company

Contractor _____

SECTION PLAT

		o	

_____ Ft. from N. Line

990 Ft. from S. Line

_____ Ft. from E. Line

990 Ft. from W. Line

ABANDONED

Location _____

Rig up _____

Drilling and Remarks:

Plugged

9/8/31

RECORD

Cased _____ in., _____ ft.

Sand _____

Gas _____

Oil _____

Total Depth 3379 ^{ft}

PRODUCTION

1st 24 hrs. Nat. _____

1st 24 hrs. after shot _____

Gas _____ Cu. Ft.

Dry Hole _____

Abandoned _____

Date

JAN 30 1932

19

CHAS. L. SHERWOOD

Scout