


Map No. KANSAS Sec. 1 Twp. 26 R. 1W

Well No. 14- Wilson Farm  
Warris & Kelly Oil Company

NORTH

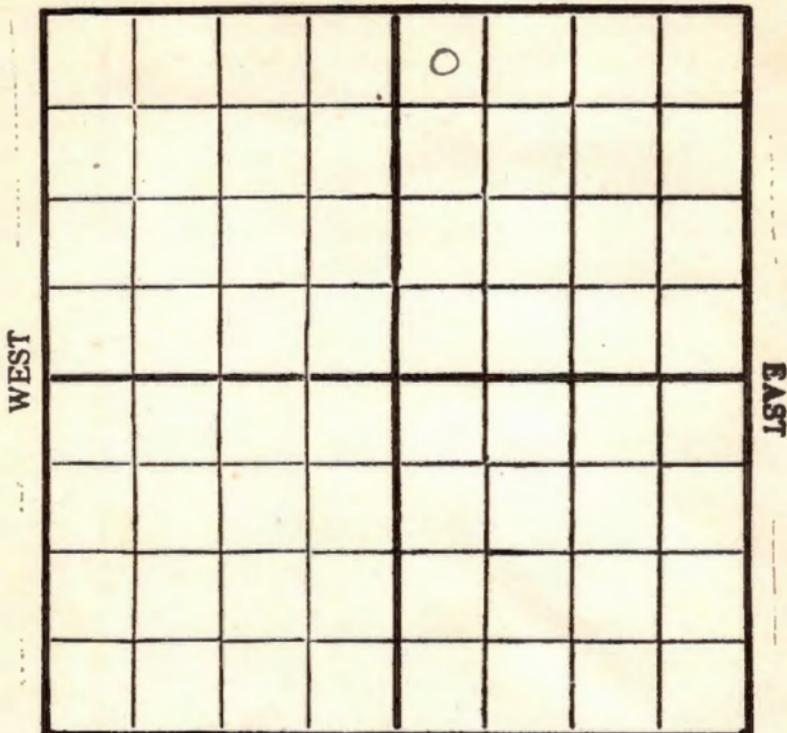

SOUTH

Location \_\_\_\_\_

Drilling Remarks \_\_\_\_\_

Rig Up \_\_\_\_\_

Drilling Remarks \_\_\_\_\_

\_\_\_\_\_

\_\_\_\_\_

RECORD

PRODUCTION

Cased \_\_\_\_\_ in. \_\_\_\_\_ ft.

Sand \_\_\_\_\_

Gas \_\_\_\_\_

Oil \_\_\_\_\_

Total Depth \_\_\_\_\_

1st 24 hrs. Nat. \_\_\_\_\_

1st 24 hrs. after shot \_\_\_\_\_

Gas \_\_\_\_\_ cu. ft. \_\_\_\_\_

Dry Hole \_\_\_\_\_

Abandoned \_\_\_\_\_

Map No. **KANSAS** Sec. 1 Twp. 26 R. 1<sup>w</sup>

Well No. 14 - Nelson Farm


Davis & Kelly Oil Company

330 Ft. from N. Line

\_\_\_\_\_ Ft. from S. Line

\_\_\_\_\_ Ft. from E. Line

330 Ft. from W. Line

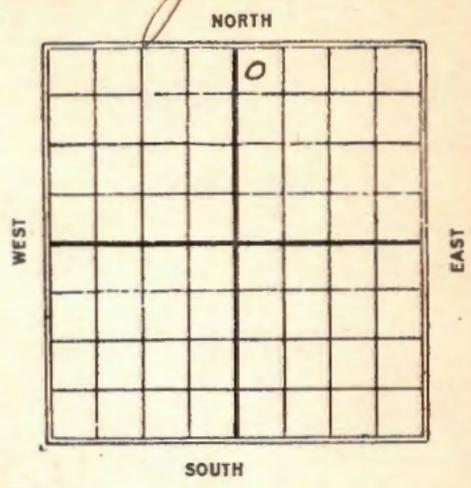

1929

Date

REPORT

Date	REPORT
9/24	Reyn up.
10/2	Waly 885'
10/9	" 1970'
10/16	" 2625
10/23	Top Chat, 3029 daly 3160'
10/30	Simpson 3368-75' T.D. 3375' swab 200 bbl oil somp.

Sec. One

Map No. **KANSAS** Sec. 1 Twp. 26 R. 1W

39 1-26-14

Well No. 14 Wilson

Davis & Kelly Oil Company

Contractor

SECTION PLAT

330 Ft. from N. Line

..... Ft. from S. Line

..... Ft. from E. Line

330 Ft. from W. Line

		0	

FIRST REPORTS

Location.....

Rig up.....

Drilling and Remarks:

*Rigging up*

RECORD

Cased.....in., .....ft.

Sand.....

Gas.....

Oil.....

Total Depth.....

PRODUCTION

1st 24 hrs. Nat.....

1st 24 hrs. after shot.....

Gas.....Cu. Ft.

Dry Hole.....

Abandoned.....

Date

SEP 25 1929

S. J. LEWIS Scout

*Sealgwick*

Map No. **KANSAS** Sec. 1 Twp. 26 R. 1W

39

Well No. 14 Wilson

*Janis & Skelly Oil* Company

Contractor

**SECTION PLAT**

330 Ft. from N. Line

..... Ft. from S. Line

..... Ft. from E. Line

330 Ft. from W. Line

		0	
1			

**COMPLETED**

Location.....

Rig up.....

Drilling and Remarks:

*Surf 3868-75*

*Coat 200 8 1/2*

**RECORD**

Cased.....in., .....ft.

Sand.....

Gas.....

Oil.....

Total Depth 3325

**PRODUCTION**

1st 24 hrs. Nat.....

1st 24 hrs. after shot.....

Gas.....Cu. Ft.

Dry Hole.....

Abandoned.....

Date

**OCT 30 1929**

192

**S. J. LEWIS**

Scout