

Map No. _____ Sec. 1 Twp. 26 R. 1W

Well No. 15 Wilson Farm


Solar + Skelly Company

_____ Ft. from N. Line

660 Ft. from S. Line

_____ Ft. from E. Line

660 Ft. from W. Line

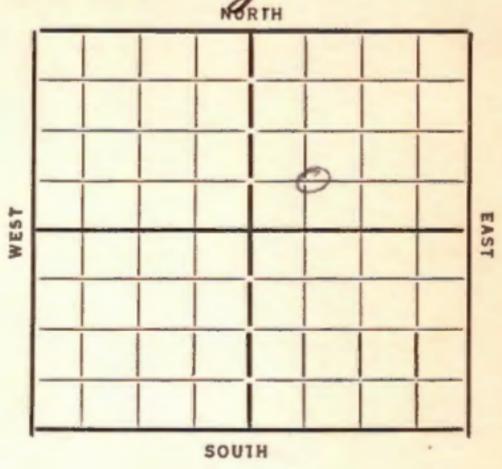

Date
1933

REPORT

8/9 moving in

8/17 Rig

8/23 —

8/30 —

9/6 —

9/13 —

9/20 —
9/29 Abldg 1025
10/5 — 2200'

10/11 K.C. 2533 - Ry 2570-75-
Swab 32 bbls in 36 hrs

Abldg 2593

10/18 T.D 2597 - pump 40 bbls
5 1/2 hrs - will acidize

10/25 K.C. Lene 2533
T.D. 2597 1000 gal acid
pump 8 bbls per hr

COMPLETED

Map No. 39 Sec. 1 Twp. 26 R. 1W

Well No. 15 - Wilson

Solow & Skelley Company

Contractor

SECTION PLAT

		●	

.....Ft. from N. Line

660 Ft. from S. Line

.....Ft. from E. Line

660 Ft. from W. Line

FIRST REPORTS

Location.....

Rig up.....

Drilling and Remarks:

moving in

RECORD

Cased.....in.,ft.

Sand.....

Gas.....

Oil.....

Total Depth.....

PRODUCTION

1st 24 hrs. Nat.....

1st 24 hrs. after shot.....

Gas.....Cu. Ft.

Dry Hole.....

Abandoned.....

Date

5/9/33 192 O. Mannich Scout

Map No. 39 Sec. 1 Twp. 26 R. 1W

Well No. 15 - Wilson

Sloan + Skelly Company

Contractor

SECTION PLAT

		0	

Ft. from N. Line

660 Ft. from S. Line

Ft. from E. Line

660 Ft. from W. Line

COMPLETED

Location

Rig up

Drilling and Remarks:

1000 gal acid
pumps 8 bbls
per hr

RECORD

Cased _____ in., _____ ft.

Sand K.P. line 2533

Gas _____

Oil _____

Total Depth 2597

PRODUCTION

1st 24 hrs. Nat. _____

1st 24 hrs. after shot _____

Gas _____ Cu. Ft.

Dry Hole _____

Abandoned _____

Date

10-25-33 192 O. Munnich Scout