


Section 35 Township 26 Range 1W

Well No. #2 Petrie

Company Drg. Prod.

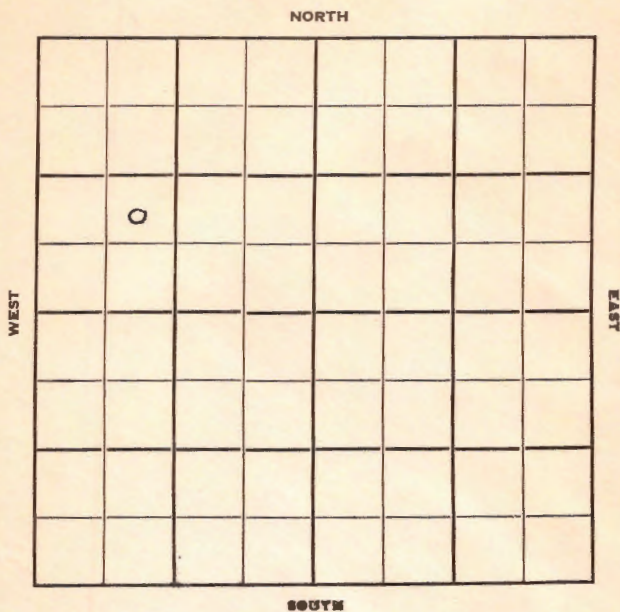

Sec. 35 Twp. 26 R. 1W

Well No. #2 Petrie Farm

Drlg. Prod.

Company

Contractor

Ft. from N. Line

990'


Ft. from S. Line

Ft. from E. Line

990'

Ft. from W. Line

NE SW NW

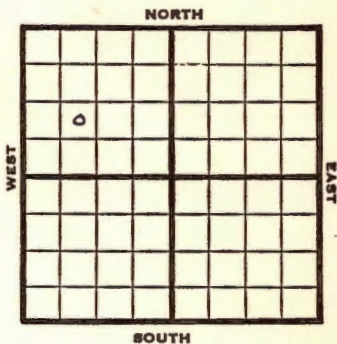

1951

Elev. 1332' REPORT

8/8

Spud 7-31-51
8" @ 225
Drlg. 2380'

11/14

Spud 7-31-51
Oil Well TD 3468
8" @ 225
Lans. 2329 KC 2608
DST 2723-27 open 45 min.
Rec. 10' O&WCM 170' SW
Miss. 3100 Kh. 3310
Viola 3446 Simp. 3454
DST 3451-55 open 15 min.
Rec. 150' oil 75' O&GCM 1275' wtr.
DST 3455-60 open 20 min.
Rec. 240' sul. wtr. TD 3468
5" @ 3465 CO to 3458 4/ 3445-47
FU 1600' wtr. SSO sq. off
11/3445-47 P/ 900 BW 10 BOPD
11/ 3452-55 wtr. SP 3448 sq. off
250 A. Comp. 30 BOPD

COMPLETED

County **Sedgwick** State **Kansas**

Sec. **35** (Blk. **26**) (Sur. Rge.) **1W** Map No.

Operator **Drlg. Prod.**

Well No. **2** Farm **Petrie**

Elev. **1332** Location **NE SW NW**

0 FIRST REPORT

990 Ft. From **S** Line **NW**

990 Ft. From **W** Line **Quarter**

1st. Report **AUG 8 1951**

Completion

Remarks

Spudding Date **7-31-51**

Drlg. Data

8" @ 225 drlg. 2380

J. E. TYRA

County Sedgwick State Kansas

Sec. 35 (Blk. 2 Twp. 6) (Sur. 1W Rge.) Map No.

Operator Drlg. Prod.

Well No. 2 Farm Petrie

Elev. 1332 Location NE SW NW

990 Ft. From S Line NW

990 Ft. From W Line Quarter

1st. Report

Completion NOV 14 1951

Remarks

Spudding Date 7-31-51

Drlg. Data Oil well TD 3468

8" @ 225 Lans. 2329 KC 2608

DST 2723-27 open 45 min. Rec. 10' o &

wcm 170' sw Miss. 3100 Kh. 3310

Viola 3446 Simp. 3454 DST 3451-55

open 15 min. Rec. 150' oil 75' o & gcm

1275' water DST 3455-60 open 20 min.

Rec. 240' sul. water TD 3468 5" @ 3465

CO to 3458 4/ 3445-47 FU 1600' water SSO

sq. off 11/ 3445-47 P/ 900 bw 10 bopd

14/ 3452-55 water SP 3448 sq. off

250 A Comp. 30 bopd

J. E. TYRA