


Section 36 Township 26 Range IW

Well No. 2 Petrie

Company British American

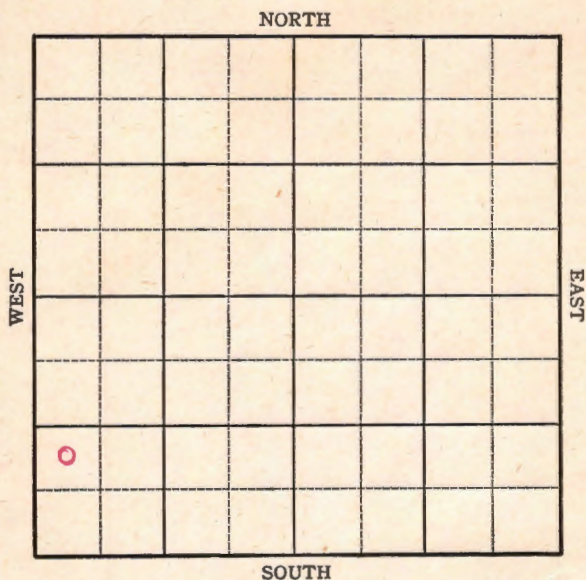

Sec. 36 Twp. 26 R. 1-W

Well No. #2 Petrie Farm


British American Company

_____ Ft. from N. Line

990 Ft. from S. Line

_____ Ft. from E. Line

330 Ft. from W. Line

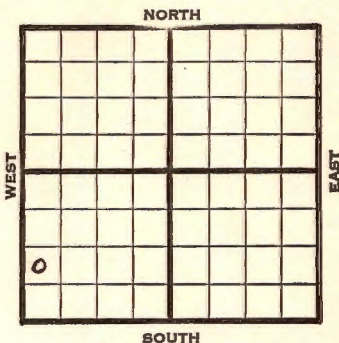

NW SW SW Elev. 1324

1945

REPORT

7/18

Location

7/26

RUR

8/1

9" @ 123

Drlg. 1526

8/8

Topoka 1660

Lans 2285

KC 2572

BKC 2742

Miss. 3041

Drlg. 3140

8/15

B Miss 3223

Simp 3387

TD 3389'

5" @ 3387 Rec. 2100' oil

8/22

Flow 18 fluid in 7 hrs.

Swab 30 fluid per hr. 6 hrs.

18% Wtr. PB 3390

8/29

Simp. 3387

5" @ 3387

PB 3390

TD 3392

Pump 417 oil plus 104 W Pot.

Grav. 39.9

COMPLETED

KANSAS Pool Name Wildcat
 Kansas

Map No. 39 Sec. 36 Twp. 26 R. 1W

Well No. 2 Petrie

Birtish American Company

FIRST REPORT Contractor
 NW SW SW

SECTION PLAT

 Ft. from N. Line

990 Ft. from S. Line

 Ft. from E. Line

330 Ft. from W. Line

Sedgwick County

Location X

Rig up

Drilling and Remarks:

RECORD

Cased in., ft.

Sand

Gas

Oil

Total Depth

PRODUCTION

1st 24 hrs. Nat.

1st 24 hrs. after shot

Gas Cu. Ft.

Dry Hole

Abandoned

Date

JUL 1 8 1945

19

S. J. LEWIS Scout

KANSAS

Kansas Pool Name Wildcat

Map No. 39 Sec. 36 Twp. 26 R. 1W

Well No. 2 Petrie

British American Company

COMPLETED Contractor

NW SW SW

E 11, 1324

SECTION PLAT

0			

_____ Ft. from N. Line

990 Ft. from S. Line

_____ Ft. from E. Line

330 Ft. from W. Line

Sedgwick County

Location _____

Rig up _____

Drilling and Remarks:

Comp 3387
5" @ 3387
PB 3390
Pump 417 oil + 104 W
Pot.
39 E 4

RECORD

Cased _____ in., _____ ft.

Sand _____

Gas _____

Oil _____

Total Depth 3392

PRODUCTION

1st 24 hrs. Nat. _____

1st 24 hrs. after shot _____

Gas _____ Cu. Ft.

Dry Hole _____

Abandoned _____

Date

AUG 29 1945 19

S. J. LEWIS Scout