


Section 36 Township 26 Range IV

Well No. 3 Petrie

Company British-American

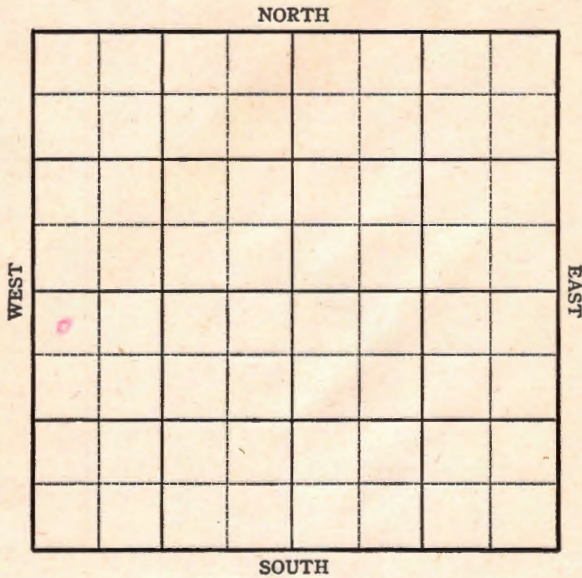

Sec. 36 Twp. 26 R. 1-W

Well No. #3 Petrie Farm


British-American Company

330 Ft. from N. Line

_____ Ft. from S. Line

_____ Ft. from E. Line

330 Ft. from W. Line

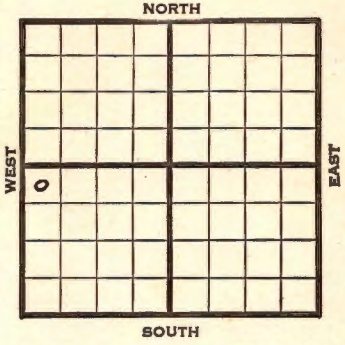

NW SW **Elev. 1326**

1945	REPORT
8/29	Location
9/5	9" @ 170 Drlg. 270
9/12	Topeka 1660 B. Oread 2115 KC. 2960
	Drlg.
9/19	Pawnee 2827 Miss. 3042 Viola 3393-3394
	TD 3394 Run csg.
9/26	Miss. 3044 Viola 3395 corrected 7" @ 3395
	Drlg. 3405
10/3	Simp Sd 3405-3408 TD 3408 PB 3387 5 shots 2721-2725 5 shots 2728-2731 TD 3408 Run liner
10/10	33' of 5" liner @ 3408 TD 3455' SWD
10/17	" " " "
10/24	Simp Sd. 3405 TD 3455' SWD

ABANDONED

KANSAS Kansas Pool Name No Name

Map No. 39 Sec. 36 Twp. 26 R. 1W

Well No. 3 Petrie

British-American Company

FIRST REPORT

Contractor

NW SW

SECTION PLAT

330 Ft. from N. Line

_____ Ft. from S. Line

_____ Ft. from E. Line

330 Ft. from W. Line

o			

Sedwick

Location x

Rig up _____

Drilling and Remarks:

RECORD

Cased _____ in., _____ ft.

Sand _____

Gas _____

Oil _____

Total Depth _____

PRODUCTION

1st 24 hrs. Nat. _____

1st 24 hrs. after shot _____

Gas _____ Cu. Ft.

Dry Hole _____

Abandoned _____

Date

AUG 29 1945 19

S. J. LEWIS Scout

KANSAS

Kansas Pool Name Petrie

Map No. 39 Sec. 36 Twp. 26 R. 1W

Well No. 3 Petrie

British-American Company

ABANDONED

Contractor

NW SW

E 1,1326
SECTION PLAT

330 Ft. from N. Line

_____ Ft. from S. Line

_____ Ft. from E. Line

330 Ft. from W. Line

o			

Sedgwick County

Location _____

Rig up _____

Drilling and Remarks:

Shut in 8455

SWD

RECORD

Cased _____ in., _____ ft.

Sand _____

Gas _____

Oil _____

Total Depth 8455

PRODUCTION

1st 24 hrs. Nat. _____

1st 24 hrs. after shot _____

Gas _____ Cu. Ft.

Dry Hole _____

Abandoned _____

Date

OCT 24 1945 19

S. J. LEWIS Scout