


Section 34 Township 26 Range 1-W

Well No. 1 Gasell (Gasell)

Company H. A. Hershefield

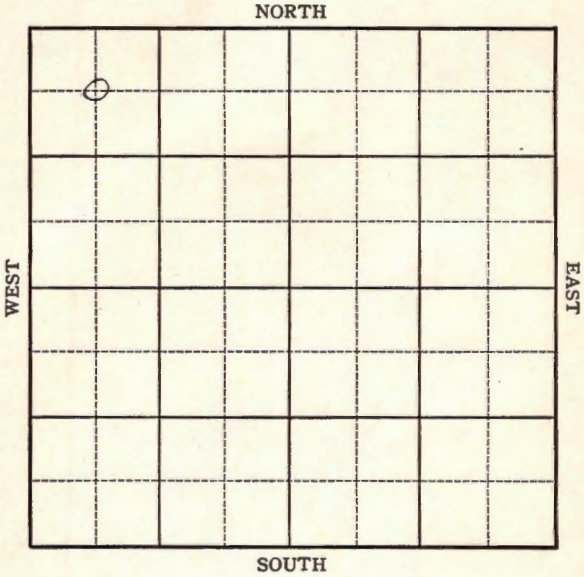

Sec. 34 Twp. 26 R. 1-W

Well No. #1 Gasell Farm

H. A. Hershefield Company


660 Ft. from N. Line

_____ Ft. from S. Line

_____ Ft. from E. Line

660 Ft. from W. Line

Elev. 1334

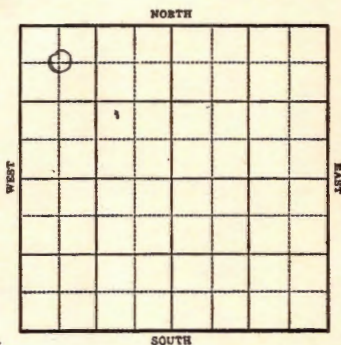

1943

R E P O R T

11/17 Location.

11/24 Rotary

12/1 "

12/8 "

12-15 8" at 120'
Drlg. 915'

12/22 SD

12/29 "

1944

1-5 TD 1000' skid rig 24' East
10" @ 125
WOC

1-12 Drlg 1788'

1/19 Drlg. 2800
Lans 2530'

1/26 Drlg. 3237'

2/2 Miss 3119
Viola 3368

Drlg 3380

2/9 Viola 3328
Simpson 3356

TD 3501

ABANDONED

Sedgwick

KANSAS

Map No. 39 Sec. 34 Twp. 26 R. 1WWell No. 1 GasellH. A. Hershefield Company

FIRST REPORT Contractor

C SW NW

SECTION PLAT

660 Ft. from N. Line Ft. from S. Line Ft. from E. Line660 Ft. from W. Line

o			

Wildcat

Location XRig up

Drilling and Remarks:

RECORD

Cased in., ft.Sand Gas Oil Total Depth

PRODUCTION

1st 24 hrs. Nat. 1st 24 hrs. after shot Gas Cu. Ft.Dry Hole Abandoned

Date

NOV 17 1943 19S. J. LEWIS Scout

Map No. **KANSAS** 29 Sec. 34 Twp. 26 R. 1W

Well No. 1 Gasell

H. A. HERSHEFIELD Company

ABANDONED Contractor

C NW NW

SECTION PLAT

660 Ft. from N. Line

_____ Ft. from S. Line

_____ Ft. from E. Line

660 Ft. from W. Line

a			

Wildcat

Location _____

Rig up _____

Drilling and Remarks:

Vista 3328
Simpson 3356

RECORD

Cased _____ in., _____ ft.

Sand _____

Gas _____

Oil _____

Total Depth 3501

PRODUCTION

1st 24 hrs. Nat. _____

1st 24 hrs. after shot _____

Gas _____ Cu. Ft.

Dry Hole _____

Abandoned _____

Date

FEB 9 1944 19

S. J. LEWIS Scout