
KANSAS
FORM 51 5M 10-41 PETROL

Sedgwick

Section 12 Township 26 Range 1-W

Well No. #1 Adamson

Company Prunty Production

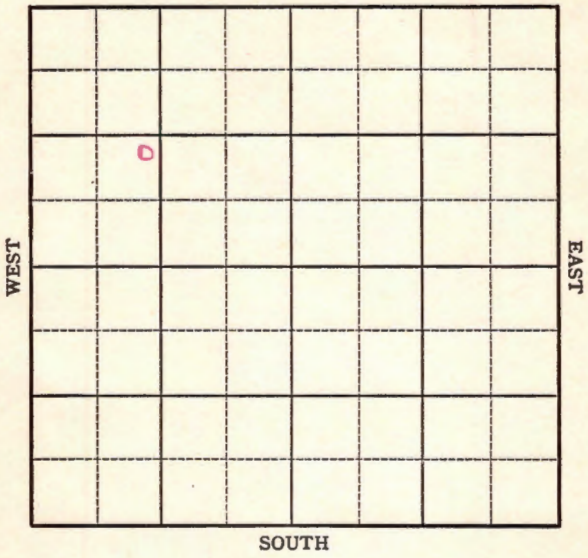

Form 252-A
5M 5-42 Petrol

KANSAS

Sedgwick

Sec. 12 Twp. 26 R. 1-W

Well No. #1 Adamson Farm

Prunty Production Company


Goodrich pool

_____ Ft. from N. Line

990 Ft. from S. Line

_____ Ft. from E. Line

990 Ft. from W. Line

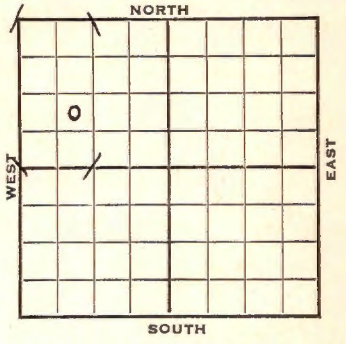

NE SW NW. Elev. 1345

1942	REPORT
12/16	Drk.
12/22	10" @ 155' Drlg. 630'
12/29	Drlg. 2633
1943 1/6	Miss. 3020 Misener 3335 T. D. 3336' Run 5"
1/13	5" Casing set 3335 CO
1/20	500 acid.
1/27	" "
2/3	Misener 3335 5" casing set 3335' T.D. 3336' 500 acid Pump 65 bbl oil plus 600 bbl water. Pot. 39 Gravity

COMPLETED

Form 26 200 Bks 5-42 Petrol

Sedgwick

KANSAS

Map No. 39 Sec. 12 Twp. 26 R. 1W


Well No. 1 Adamson

Prunty Production Company

COMPLETED Contractor

NE SW NW

SECTION PLAT

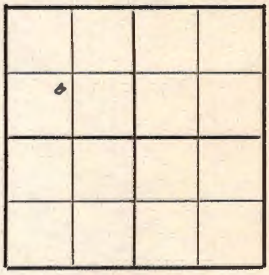

____ Ft. from N. Line

990 Ft. from S. Line

____ Ft. from E. Line

990 Ft. from W. Line

GOODRICH POOL

Location

Rig up

Drilling and Remarks:

Mr. Ener 3335

5" @ 3335

500 acid

Pump. 65 oil + 600 Wtr

RX

89° Gr

RECORD

Cased ____ in., ____ ft.

Sand

Gas

Oil

Total Depth 3336

PRODUCTION

1st 24 hrs. Nat.

1st 24 hrs. after shot

Gas ____ Cu. Ft.

Dry Hole

Abandoned

Date

FEB 3 1943 19 S. J. LEWIS Scout

Form 26 200 Bks 5-42 Petrol

KANSAS

Sedgwick

Map No. 39 Sec. 12 Twp. 26 R. 1W

Well No. 1 Adamson

Prunty Production Company

FIRST REPORT Contractor

NE SW NW


Ft. from N. Line

990 Ft. from S. Line

Ft. from E. Line

990 Ft. from W. Line

SECTION PLAT

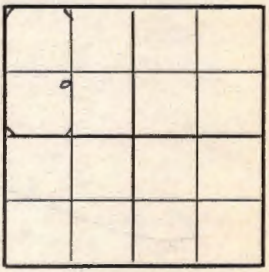

GOODRICH POOL

Location

Rig up

Drilling and Remarks:

Derrick

RECORD

Cased in., ft.

Sand

Gas

Oil

Total Depth

PRODUCTION

1st 24 hrs. Nat.

1st 24 hrs. after shot

Gas Cu. Ft.

Dry Hole

Abandoned

Date

DEC 16 1942 19 S. J. LEWIS Scout