

Sedgwick


KANSAS

SECTION 12 TOWNSHIP 26 RANGE 1 W

WELL NO. #1 Corr

COMPANY Cities Service

NORTH

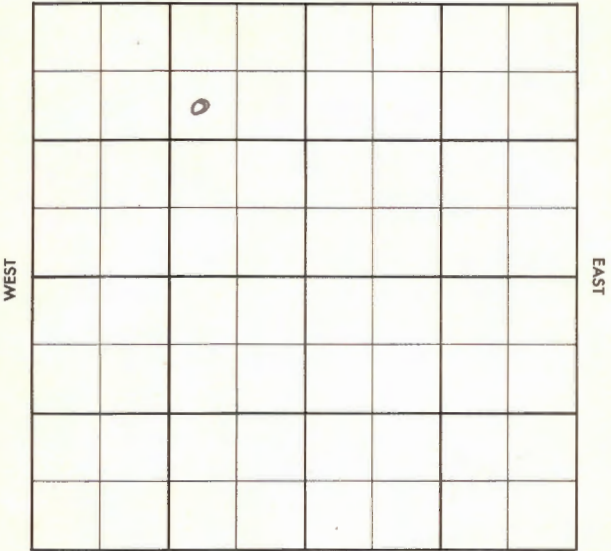

SOUTH

Sedgwick

KANSAS

SEC.	TWP.	R.
12	26	1W

WELL NO.

#1 Corr

FARM

COMPANY

Cities Service

CONTRACTOR

White & Ellis


Valley Center

_____ Ft. from N. Line

_____ Ft. from S. Line

_____ Ft. from E. Line

_____ Ft. from W. Line

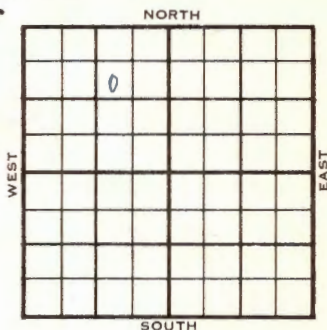

SW NE NW


1956	ELEVATION	REPORT
	1344'	
2-1	RUR	
5-2	Comm. 1-31-56	
	10" @ 206 w/280	
	DST 2577-95 op 1 hr. rec. 32' sw, 1240#	
	DST 2605-36 op 1 hr. rec. 75' mud, 825#	
	DST 2666-83 op 1 hr. rec. 110' msw,	
	810/30"	
	DST 3022-33 op 1 hr. rec. 35' mw,	
	900/30"	
	DST 3333-41 op 1 hr. rec. 930' oil, 60'	
	ocm, 1923' gcsw, 1240/30"	
	7" @ 3340/200	
	CO to 3341	
	S/ 47 bo, 338 bw, 6½ hrs.	
	P/ 16 bo, 1064 bw 24 hrs.	
	Comp. 62 bopd, 2308 bw	
	L. 2350	
	KC 2546	
	BKC 2721	
	M. 3023	
	V. 3337	
	TD 3341'	
		COMPLETED

County **Sedgwick** Elev. _____
 Sec. **12** Twp. **26** Rge. **14**
 Company **Cities Service**
 Farm Name **Corr** No. **1**

TOPS	DEPTH	LOG	DATUM
Anb.			
Tr.			
H.			
Tr.			
Dg.			
Bl.			
L.			
K.C.			
B.K.C.			
Ce.			
C.			
M.			
M.			
K.			
Mz.			
Mo.			
V.			
S.			
S.			
A.			
R.			
Pe.			
G.			
T.D.			

Loc. in Sec. **SW NE NW**
 Geol. _____
 Contr. **White & Ellis**
 Pool **Valley Center**
 FEB 1 1956
 FIRST REPORT

Date Comm. **RUR**

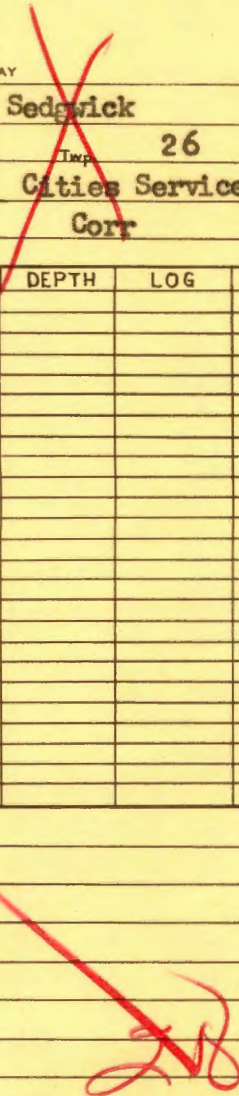

Co.
 No.
 No.
 Sec.
 T.
 R.

County **Sedgwick** Elev. **1344**
 Sec. **12** Twp. **26** Rge. **1W**
 Company **Cities Service**
 Farm Name **Corr** No. **1**

TOPS	DEPTH	LOG	DATUM	Loc. in Sec.
Anh.				SW NE NW
TP.				
H.				
Tr.				
Dg.				Geol.
Bl.				
L.	2350		1006	Contr.
K.C.	2546		1202	
B.K.C.	2721		1377	White & Ellis
Ce.				
C.				Pool
M.	3023		1679	
M.				Valley Center
K.				
Mz.				COMPLETE
Me.				
V.	3337		1993	
S.				
S.				COMPLETE
A.				
R.				COMPLETE
PE.				
G.				COMPLETE
TD.	3341			

Date Comm. **1-31-56** MAY 2 1956

10" @ 206/280 DST 2577-95 open 1 hr.
 rec. 32' sw 1240# DST 2605-36
 open 1 hr. rec. 75' mud 825#
 DST 2666-83 open 1 hr. rec. 110' msw
 810/30" DST 3022-33 open 1 hr.
 rec. 35' mw 900/30" DST 3333-41
 open 1 hr. rec. 930' oil 60' ocm
 1923' gcsw 1240/30" 7" @ 3340/200

OVER

CO to 3341 S/ 47 bo 338 bw $6\frac{1}{2}$ hr.

P/ 16 bo 1064 bw 24 hr.

Comp. 62 bopd 2308 bw

R. G.

MAY 9 1956