


Map No. **KANSAS** Sec. 12 Twp. 26 R. 1^w

Well No. 1 Lantz Farm
Bu-Vi Bar Company

_____ Ft. from N. Line
990 Ft. from S. Line
380 Ft. from E. Line
_____ Ft. from W. Line

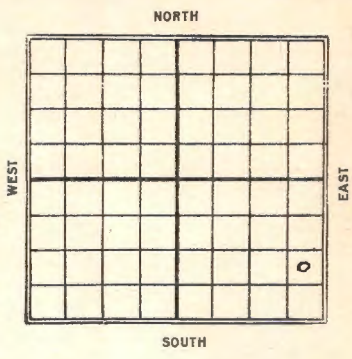

1928

Date	REPORT
8/29	R.P.G.
9/5	Spud
9/12	Orly 430
9/19	" 1100'
9/26	T.D. -1295' - U/R 12"
10/3	Orly 1340'
10/10	" 1999'
10/17	" 2375'
10/24	" 2508'
10/31	T.D. 2658 U/R 8"
"/17	Orly 2714'
"/14	T.D. 3015' - U/R 8"
"/21	Top chat 3015'
	show of oil 3056'
	Orly 3075'
"/30	" 3245'
12/5	B.L. 3267' - 6" cem 3250
	T.D. 3335' T.B.P.
12/9	made 496 bbls 15 hrs
12/10	made 829 " 24 "
12/8	Pay 3363 - 3367' T.D.
	Flowing 45 bbls per hr.
	Telegram

12/9-496 bbls - 15 hrs
 12/10-829 " 24 hrs.
 12/11-819 "
 12/12-836 "
 12/13-804 "

12/12- Ray 3363-67'
 T.D. 3367'

Flowing 829 bbls
 in 24 hrs.

Pump

12/14-821 bbls. 3/19-175 bbls.
 12/15-819 " 3/21-151 "
 12/16-815 " 3/22-12 "
 12/17-783 " still put on
 pump.
 12/18-774 "
 12/19-842 " 3/23-458 bbls
 on pump.
 12/20-796 "
 12/21-825 " 3/25-768 on pump.
 12/29-794 " 3/26-744 " "
 1929 3/28-740 " "
 1/21-718 " 4/1-724 "
 1/25-716 " 4/5-612 "
 1/28-721 " 4/9-396 "
 1/28-710 "
 1/29-718 "
 2/1-715 "
 2/2-718 "
 2/4-729 "
 2/7-718 "
 2/9-708 "
 2/16-682 "
 2/20-659 "
 2/21-661 "
 2/23-585 "
 2/26-563 "
 3/5-526 "
 3/7-471 "
 3/8-448 "
 3/11-456 "
 3/12-423 "
 3/14-361 "
 3/16-270 "
 3/18-198 "
 tubing

Scout

MAP NO. *110* SEC. *12* TWP. *26* R. *1 W*

WELL NO. *1 Santy*

Bur-Ed Bar COMPANY

CONTRACTOR

SECTION PLAT

			0

_____ FT. FROM N. LINE

990 FT. FROM S. LINE

380 FT. FROM E. LINE

_____ FT. FROM W. LINE

FIRST REPORTS

RECORD

LOCATION _____

CASED _____ IN., _____ FT.

RIG UP _____

SAND _____

DRILLING AND REMARKS:

GAS _____

ROG

OIL _____

TOTAL DEPTH _____

PRODUCTION

1ST 24 HRS. NAT. _____

1ST 24 HRS. AFTER SHOT _____

GAS _____ Cu. Ft.

DRY HOLE _____

ABANDONED _____

DATE

AUG 29 1928

S. J. LEWIS

192

SCOUT

Stalgwick

MAP NO. KANSAS SEC. 12 TWP. 26 R. 1 W

15125

WELL NO. 1

Bu Vi Bar COMPANY

CONTRACTOR

SECTION PLAT

			0

_____ FT. FROM N. LINE

990 FT. FROM S. LINE

330 FT. FROM E. LINE

_____ FT. FROM W. LINE

COMPLETED

LOCATION _____

RIG UP _____

DRILLING AND REMARKS:

Pay 3363 & 3367
Flowing 829 & 84
24 hrs

RECORD

CASED _____ IN., _____ FT.

SAND _____

GAS _____

OIL _____

TOTAL DEPTH 3367

PRODUCTION

1ST 24 HRS. NAT. _____

1ST 24 HRS. AFTER SHOT _____

GAS _____ CU. FT.

DRY HOLE _____

ABANDONED _____

DATE

DEC 12 1928 192

S. J. LEWIS