

KANSAS


Sedgwick

FORM 51 5M 10-41 PETROL

Section 12 Township 26 Range 1-W

Well No. #1 Wright

Company Prunty Production

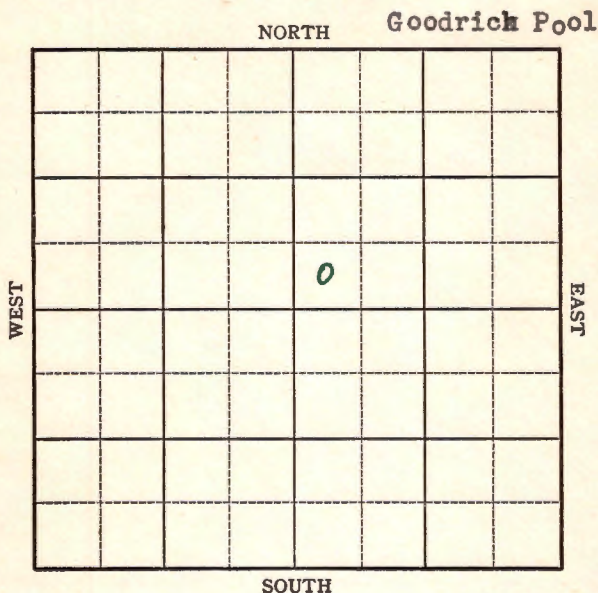

Sedgwick


KANSAS

Map No. 39 Sec. 12 Twp. 26 R. 1WWell No. 1 WrightPrunty Production Company

Contractor

FIRST REPORT
SW NE

SECTION PLAT

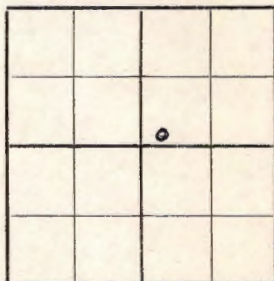 Ft. from N. Line330 Ft. from S. Line Ft. from E. Line330 Ft. from W. Line**GOODRICH POOL**Location Rig up

Drilling and Remarks:

10" - 161'Waiting on
cement to set

RECORD

Cased in., ft.Sand Gas Oil Total Depth

PRODUCTION

1st 24 hrs. Nat. 1st 24 hrs. after shot Gas Cu. Ft.Dry Hole Abandoned

Date

DEC 17 1941

19

S. J. LEWIS

Scout

Map No. 39 Sec. 12 Twp. 26 R. 1WWell No. 1 WrightPrunty Production CompanyCOMPLETED Contractor

SW NE

SECTION PLAT

 Ft. from N. Line330 Ft. from S. Line Ft. from E. Line330 Ft. from W. LineGOODRICH POOLLocation Rig up

Drilling and Remarks:

*Viola 3339**5" @ 3339**Pump 12 oil +
1200 Water Bx**39-48*

RECORD

Cased in., ft.Sand Gas Oil Total Depth 3340

PRODUCTION

1st 24 hrs. Nat. 1st 24 hrs. after shot Gas Cu. Ft.Dry Hole Abandoned

Date

JAN 28 194219S. J. LEWIS

Scout