


Section 12 Township 26 Range 1-W

Well No. #1 Wright

Company Prunty Production

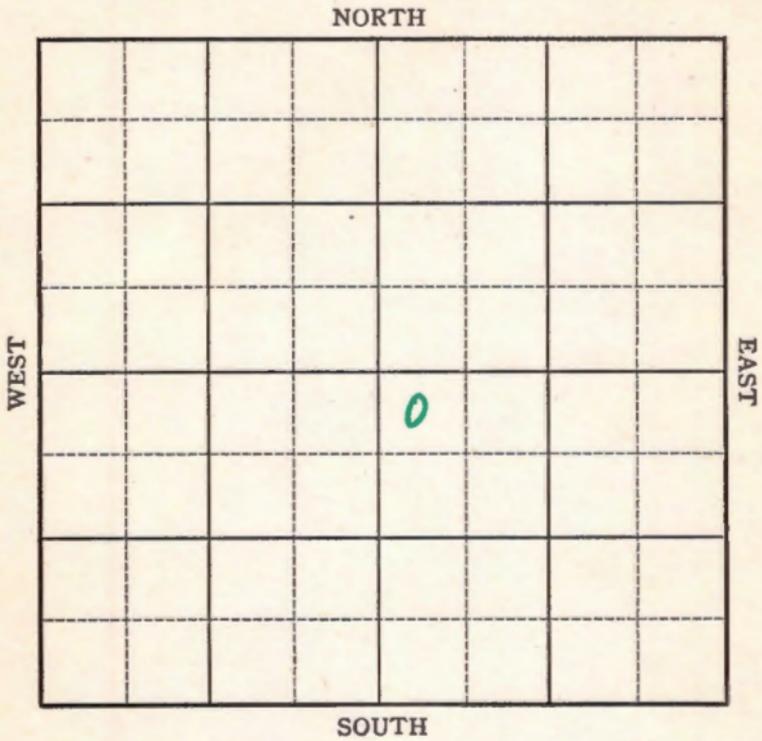


Sec. 12 Twp. 26 R. 1-WWell No. #1 Wright FarmPrunty Production Company

(Goodrich)

330 Ft. from N. Line

_____ Ft. from S. Line

_____ Ft. from E. Line

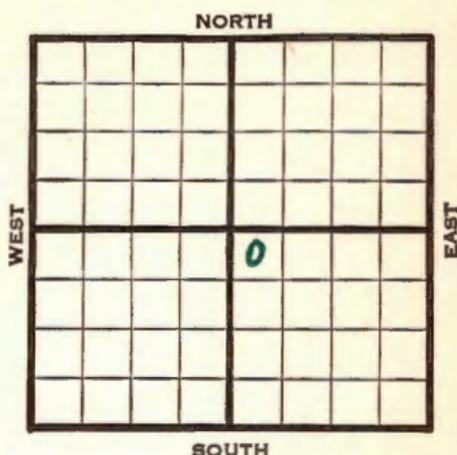330 Ft. from W. Line

Elev. 1341

1941	REPORT
9/24	Location
10/2	Derrick.
10/9	"
10/16	"
10/23	12" - 159' Drlg. 1740'
10/30	Miss. 3075' T.D. 3169' Fsg.
11/6	Misener 3336' 7" - 3336'
	T.D. 3338' RUST.
11/13	2080' oil.
11/20	1000 acid. Pump 101 oil & 533 water 24 hours.
11/25	Misener 3336'
	7" - 3336'
	T.D. 3338'
	1000 acid.
	Pump 101 oil & 533 water.
	39. Gravity
	COMPLETED

Map No. K-39 Sec. 12 Twp. 26 R. 1W

Well No. 1 Wright

Prunty Production Company

FIRST REPORT

Contractor

NW SE

330 Ft. from N. Line

_____ Ft. from S. Line

_____ Ft. from E. Line

330 Ft. from W. Line

SECTION PLAT

		o	

GOODRICH POOL

Location _____

Rig up _____

Drilling and Remarks:

RECORD

Cased _____ in., _____ ft.

Sand _____

Gas _____

Oil _____

Total Depth _____

PRODUCTION

1st 24 hrs. Nat. _____

1st 24 hrs. after shot _____

Gas _____ Cu. Ft.

Dry Hole _____

Abandoned _____

Date

SEP 24 1941

19

S. J. LEWIS

Scout

Map No. K-39 Sec. 12 Twp. 26 R. 1W

Well No. 1 Wright

Prunty Production

Company

COMPLETED

Contractor

NW SE

SECTION PLAT

330 Ft. from N. Line

_____ Ft. from S. Line

_____ Ft. from E. Line

330 Ft. from W. Line

		o	

GOODRICH POOL

RECORD

Location _____

Cased _____ in., _____ ft.

Rig up _____

Sand _____

Drilling and Remarks:

Gas _____

Musnel 3336

Oil _____

7" @ 3336

Total Depth 3337

1000 acid

Pump 101 oil +

533 Wa Tot.

39 @ 34

PRODUCTION

1st 24 hrs. Nat. _____

1st 24 hrs. after shot _____

Gas _____ Cu. Ft.

Dry Hole _____

Abandoned _____

Date

NOV 25 1941

19

S. J. LEWIS Scout