


Section 12 Township 26 Range 1-W

Well No. #1 Wright

Company ~~Cities Service~~
~~Prunty Pool~~

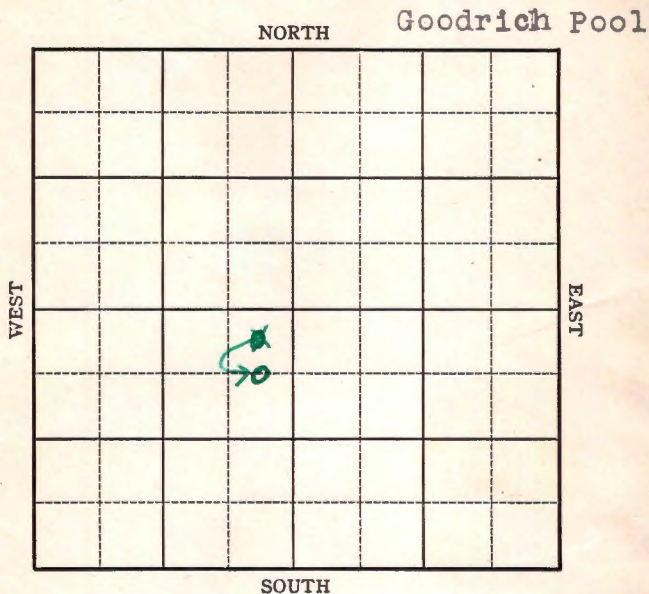

KANSAS

Sedgwick

O. W. D. D

Sec. 12 Twp. 26 R. 1-W ✓

Well No. #1 Wright Farm

Cities Service
Prunty Pool

Company

(Goodrich)

~~330~~ **605**


Ft. from N. Line

Ft. from S. Line

330

Ft. from E. Line

Ft. from W. Line

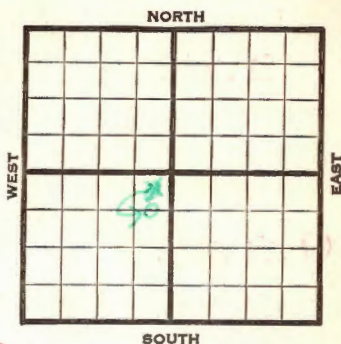

Elev. 1342

1942	REPORT
4/8	Location
4/15	10" - 161' Lans. 2450' Miss. 3002'
	Drlg. 3020'
4/22	Misener 3330$\frac{1}{2}$' 7" - 3329' RUST.
4/29	250' oil, 2000' water.
5/6	Misener 3330$\frac{1}{2}$'
	7" - 3329'
	T.D. 3332'
	Pump C8 oil plus 750 water.
	39. Gravity
	COMPLETED
1951	O. W. D. D
8/22	Lans 2450' Miss 3002' Viola 3330'
	7" @ 3329' OTD 3332' Arb. 3430'
	Drlg. @ 3918 for SWD
	OVER

1951

9/19 SWD Well TD 4243

Lans. 2450

Miss 3002

Viola 3330

7" @ 3329

OTD 3332 Arb. 3430

Lime 4154 PreCamb 4235

TD 4243

Comp. for SWD well Input 150 bwph

ABANDONED

County Sedgwick State Kansas
 Sec. 12 (Blk. 26) (Sur. 1W) Map No. _____
 Operator Cities Service
 Well No. 1 Farm Wright
 Elev. 1342 Location NE NE SW



330 Ft. From N Line SW
330 Ft. From E Line Quarter
 1st. Report _____
 Completion SEP 19 1951
 Remarks OWDD

Spudding Date _____

Drilg. Data SWD well TD 4243
Lans. 2450 Miss. 3002 Viola 3330
7" @ 3329 OTD 3332 Arb. 3430
Lime 4154 PreCamb. 4235 TD 4243
Comp. for SWD well Input 150 bwph

J. E. TYRA

Sedgwick

KANSAS

Map No. 39 Sec. 12 Twp. 26 R. 1WWell No. 1 WrightPrunty Pool

Company

FIRST REPORT

Contractor


NE SW

SECTION PLAT330 Ft. from N. Line

Ft. from S. Line

330 Ft. from E. Line

Ft. from W. Line

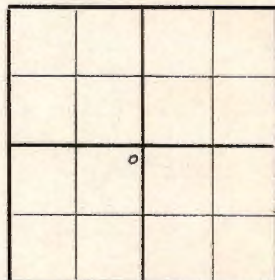**GOODRICH POOL**Location XX

Rig up

Drilling and Remarks:

RECORD

Cased _____ in., _____ ft.

Sand _____

Gas _____

Oil _____

Total Depth _____

PRODUCTION

1st 24 hrs. Nat. _____

1st 24 hrs. after shot _____

Gas _____ Cu. Ft.

Dry Hole _____

Abandoned _____

Date

APR 8 1942 19S. J. LEWIS Scout

Sedgwick


KANSAS

Map No. 39 Sec. 12 Twp. 26 R. 1WWell No. 1 WrightPrunty Production CompanyCORRECTION Contractor

C EL NE NW

605 Ft. from N. Line Ft. from S. Line330 Ft. from E. Line Ft. from W. Line

SECTION PLAT

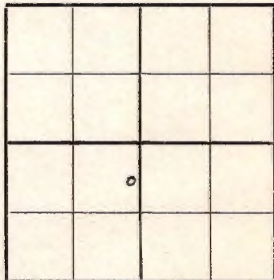GOODRICH POOLLocation Rig up

Drilling and Remarks:

Reported

NE SW

RECORD

Cased in., ft.Sand Gas Oil Total Depth

PRODUCTION

1st 24 hrs. Nat. 1st 24 hrs. after shot Gas Cu. Ft.Dry Hole Abandoned

Date

APR 22 1942

19

S. J. LEWIS Scout

Sedgwick

KANSAS

Map No. 39 Sec. 12 Twp. 26 R. 1WWell No. 1 WrightPrunty Production CompanyCOMPLETED Contractor

C E L N E S W

605 Ft. from N. Line Ft. from S. Line330 Ft. from E. Line Ft. from W. Line

SECTION PLAT

GOODRICH POOLLocation Rig up

Drilling and Remarks:

*Miscner 3330 1/2**7" @ 3328**Pump 6 Ton 4 yds**750 Water**39 e 9*

RECORD

Cased in., ft.Sand Gas Oil Total Depth 3332

PRODUCTION

1st 24 hrs. Nat. 1st 24 hrs. after shot Gas Cu. Ft.Dry Hole Abandoned

Date

MAY 6 1942 19S. J. LEWIS Scout