


Map No. **KANSAS** Sec. 12 Twp. 26 R. 1^w

Well No. 4 - Knight Farm
Bu-Vi-Bar Company

_____ Ft. from N. Line
250 Ft. from S. Line
330 Ft. from E. Line
_____ Ft. from W. Line

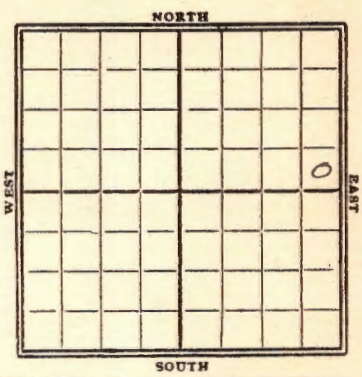

1929

| Date | REPORT |
|------|--|
| 2/19 | Bldg Rig |
| 2/27 | Rign up. |
| 3/6 | Spud |
| 3/13 | drlg 1285' |
| 3/20 | " 1948' |
| 3/27 | " 2055' |
| 4/3 | show oil 2565-70' drlg 2680' |
| 4/10 | " 2955' |
| 4/17 | " 3106' |
| 4/24 | " 3267' |
| 5/1 | 6" - 3349' Top line 3350 vert 3356 - show oil |
| 5/8 | Comp sand 3368-75 T.D. 3375 swab 1800 bbl oil Comp. |

Sealgwick

KANSAS

MAP NO. _____ SEC. 12 TWP. 26 R. 1W

WELL NO. 4 Wright

Bu-Vil Bar COMPANY

CONTRACTOR

SECTION PLAT

| | | | |
|--|--|--|---|
| | | | |
| | | | 0 |
| | | | |
| | | | |

_____ FT. FROM N. LINE

250 FT. FROM S. LINE

300 FT. FROM E. LINE

_____ FT. FROM W. LINE

FIRST REPORTS

LOCATION _____

RIG UP _____

DRILLING AND REMARKS:

Building rig

RECORD

CASED _____ IN. _____ FT.

SAND _____

GAS _____

OIL _____

TOTAL DEPTH _____

PRODUCTION

1ST 24 HRS. NAT. _____

1ST 24 HRS. AFTER SHOT _____

GAS _____ Cu. Ft.

DRY HOLE _____

ABANDONED _____

DATE

FEB 20 1929

192

S. J. LEWIS

SCOUT

Georgewick

Map No. **KANSAS** Sec. *12* Twp. *26* R. *14*

Well No. *39* *4 Knight*

Bu Vi Bar & Dal Company

Contractor

SECTION PLAT

.....Ft. from N. Line

250 Ft. from S. Line

380 Ft. from E. Line

.....Ft. from W. Line

| | | | |
|--|--|--|--|
| | | | |
| | | | |
| | | | |
| | | | |
| | | | |

COMPLETED

Location.....

Rig up.....

Drilling and Remarks:

Simpson Sand

3368-75

Swatted 1500 ft

RECORD

Cased.....in.,ft.

Sand.....

Gas.....

Oil.....

Total Depth..... *3325*

PRODUCTION

1st 24 hrs. Nat.....

1st 24 hrs. after shot.....

Gas..... Cu. Ft.

Dry Hole.....

Abandoned.....

Date

MAY 8 1929

192.....

S. J. LEWIS

Scout