
Sedgwick

Form 51—5M—2-29—34703

Map No. KANSAS Sec. 12 Twp. 26 R. 1W

Well No. 2 Lantz Farm

Bu-Vi-Bar Petrol Company

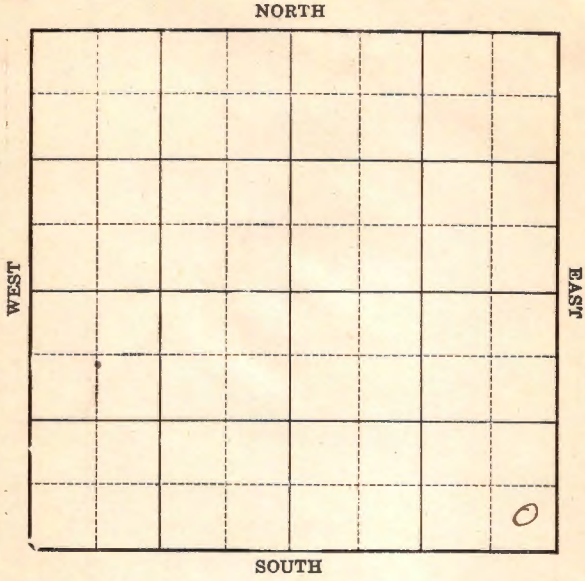

Location

Drilling Remarks

Rig Up

Drilling Remarks

RECORD

Cased in. ft.

Sand

Gas

Oil

Total Depth

PRODUCTION

1st 24 hrs. Nat.

1st 24 hrs. after shot

Gas cu. ft.

Dry Hole

Abandoned


FORM 262A-5M-12-28-PETROL

Sedgwick

Map No. KANSAS Sec. 12 Twp. 26 R. 1W

Well No. 2 Lantz Farm

Bu-Vi-Bar Petal Company

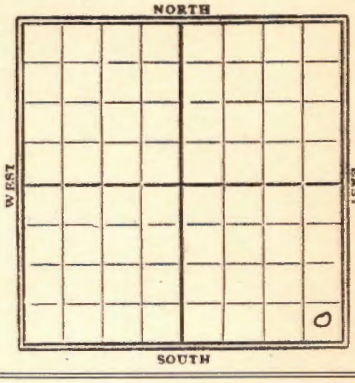

____ Ft. from N. Line

330 Ft. from S. Line

330 Ft. from E. Line

____ Ft. from W. Line

1929

Date	REPORT
4/24	Rd & G
5/1	Rigging up
5/8	Drlg 525'
5/15	" 1230'
5/22	1605 St. Ream 12" Csg
5/29	Drlg 1850'
6/5	" 2445'
6/12	" 2880'
6/19	" 3050
	Top Chat 3020'
6/26	Drlg 3215
7/2	Base Lime 3270
	6" - 3364
7/10	Lime & sd 3365-70'
	T.D. 3370'
	swab 18 bbl oil
	Comp.

Form 25—1M-6-1928


Map No. KANSAS Sec. 12 Twp. 26 R. 1 W

Well No. 2 Lantz

Buckeye Oil & Gas Company

Contractor

SECTION PLAT

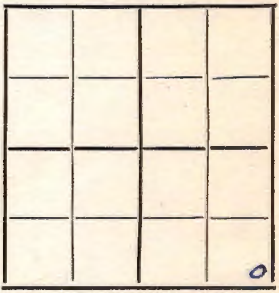

Ft. from N. Line

330 Ft. from S. Line

330 Ft. from E. Line

Ft. from W. Line

FIRST REPORTS

Location

Rig up

Drilling and Remarks:

ROG

RECORD

Cased in., ft.

Sand

Gas

Oil

Total Depth

PRODUCTION

1st 24 hrs. Nat.

1st 24 hrs. after shot

Gas Cu. Ft.

Dry Hole

Abandoned

Date

APR 24 1929

192

S. J. LEWIS Scout

Form 26—1M-Bks.-2-29

Map No. KANSAS Sec. 12 Twp. 26 R. 14W

Well No. 2 Lantz

Bu Vi Bar & Dale Company

Contractor

SECTION PLAT



____ Ft. from N. Line

330 Ft. from S. Line

330 Ft. from E. Line

____ Ft. from W. Line

COMPLETED

Location

Rig up

Drilling and Remarks:

Simpson Sand
3865-70

Show 1888 lbs

RECORD

Cased ____ in., ____ ft.

Sand

Gas

Oil

Total Depth 3370

PRODUCTION

1st 24 hrs. Nat.

1st 24 hrs. after shot

Gas ____ Cu. Ft.

Dry Hole

Abandoned

Date

JUL 10 1929 19

S. J. LEWIS Scout