


*Sedgwick*  
 Form 51-5M-9-28-27423  
 Map No. **KANSAS** Sec. *12* Twp. *26* R. *1<sup>w</sup>*  
 Well No. *3 - Sandy* Farm  
*Bu - Vi - Bar et al* Company

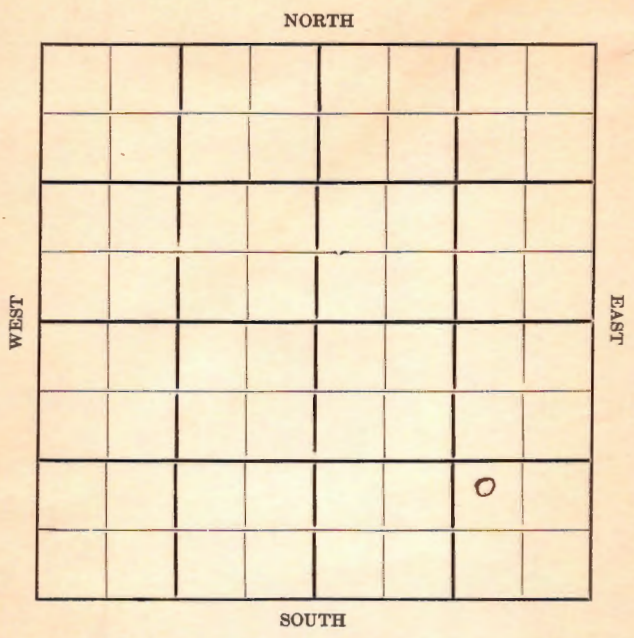

Location.....  
 Drilling Remarks  
 .....  
 .....  
 .....  
 .....  
 .....  
 .....  
 .....  
 .....  
 .....  
 .....  
 .....  
 .....  
 .....

Rig Up.....  
 Drilling Remarks  
 .....  
 .....  
 .....  
 .....  
 .....  
 .....  
 .....  
 .....  
 .....  
 .....  
 .....  
 .....  
 .....

**RECORD**

Cased..... in..... ft.  
 Sand.....  
 Gas.....  
 Oil.....  
 Total Depth.....

**PRODUCTION**

1st 24 hrs. Nat.....  
 1st 24 hrs. after shot.....  
 Gas..... cu. ft.....  
 Dry Hole.....  
 Abandoned.....

Map No. **KANSAS** Sec. *12* Twp. *26* R. *1<sup>w</sup>*

Well No. *3- Lamby* Farm


*Wu-Vi-Bar et al* Company

..... Ft. from N. Line

*1020* Ft. from S. Line

*990* Ft. from E. Line

..... Ft. from W. Line

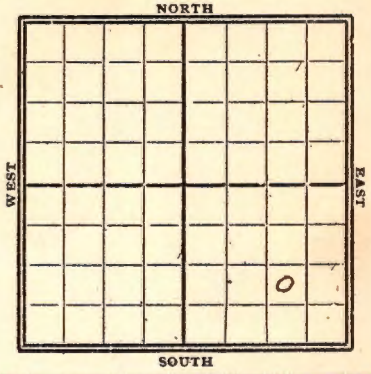

*1929*

Date

REPORT

Date	REPORT
<i>6/19</i>	<i>Location</i>
<i>6/26</i>	<i>Rign up</i>
<i>7/2</i>	<i>Wrlg 360</i>
<i>7/10</i>	<i>" 1130'</i>
<i>7/17</i>	<i>" 1635'</i>
<i>7/24</i>	<i>" 2045'</i>
<i>7/31</i>	<i>" 2660'</i>
<i>8/7</i>	<i>Top chat 3035' VIR 8"</i>
<i>8/14</i>	<i>Wrlg 3160</i>
<i>8/21</i>	<i>Wrlg 3268'</i>
<i>8/28</i>	<i>sand 3360-65'</i>
	<i>TD 3365'</i>
	<i>swab 554 bbl oil</i>
	<i>Out 2%</i>
	<i>Somp.</i>

Map No. **KANSAS** Sec. 12 Twp. 26 R. 1W

Well No. 3 Lattg

Bu Vi Bar & Dal Company

Contractor

**SECTION PLAT**

			0

.....Ft. from N. Line

1020 Ft. from S. Line

990 Ft. from E. Line

.....Ft. from W. Line

**FIRST REPORTS**

Location.....

Rig up.....

Drilling and Remarks:

**RECORD**

Cased.....in., .....ft.

Sand.....

Gas.....

Oil.....

Total Depth.....

**PRODUCTION**

1st 24 hrs. Nat.....

1st 24 hrs. after shot.....

Gas.....Cu. Ft.

Dry Hole.....

Abandoned.....

Date

**JUN 19 1929**

192

**S. J. LEWIS** Scout

Map No. **KANSAS** Sec. 12 Twp. 26 R. 1W

Well No. 3 Santa

Bu-Vi-Bar & Dal Company

Contractor

**SECTION PLAT**

..... Ft. from N. Line

1020 Ft. from S. Line

990 Ft. from E. Line

..... Ft. from W. Line

			0

**COMPLETED**

Location.....

Rig up.....

Drilling and Remarks:

Boa 48554 8 1/2

cut 2%

**RECORD**

Cased..... in., ..... ft.

Sand 3360-65

Gas.....

Oil.....

Total Depth 3365

**PRODUCTION**

1st 24 hrs. Nat.....

1st 24 hrs. after shot.....

Gas..... Cu. Ft.

Dry Hole.....

Abandoned.....

Date

**AUG 28 1920**

192.....

**S. J. LEWIS**

Scout