



KANSAS

No. Sec. 12 Twp. 26 R. 1W

Well No. 1-Wright Farm

~~Guyton~~ ~~Marland~~ Company


Bu.-Vi.-Bat

990 Ft. from N. Line

Ft. from S. Line

330 Ft. from E. Line

Ft. from W. Line

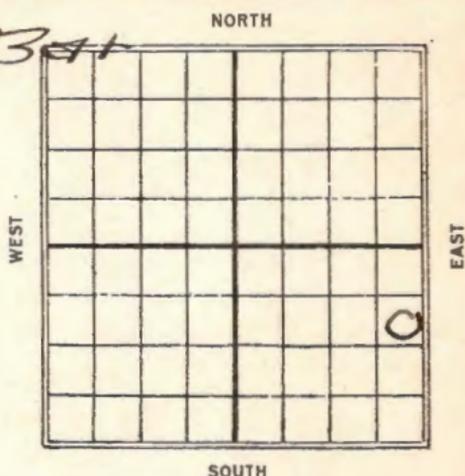


1928

Date	REPORT
3/7	Location
3/14	Rig bldg
3/21	
3/28	Rigging up-
4/4	Spud
4/11	Spud 350
4/18	Drlg 750
4/25	" 1180
5/2	" 1775
5/9	T.D. 1810 - fishing pipe -
5/16	Drlg - 1825
5/23	" 1930 - 10" @ 1805 -
5/31	" 2030
6/6	" 2365
6/13	T.D. 2365 - u.R. 10"
6/20	10 bbl show 2555 to 70
	water 2570-75 - T.D. 2580 - u.R.
6/27	Drlg 2645 - H.F.W.
7/3	T.D. 2670 - u.R. 8"
7/11	Drlg 2830
7/18	Top chert 3025 water -
	drilling 3060 -

Map No. 10 Sec. 12 Twp. 26 R. 1<sup>W</sup>  
 Well No. 1- Straight Farm  
Bu-Vi-Bal Company

990 Ft. from N. Line  
 \_\_\_\_\_ Ft. from S. Line  
330 Ft. from E. Line  
 \_\_\_\_\_ Ft. from W. Line

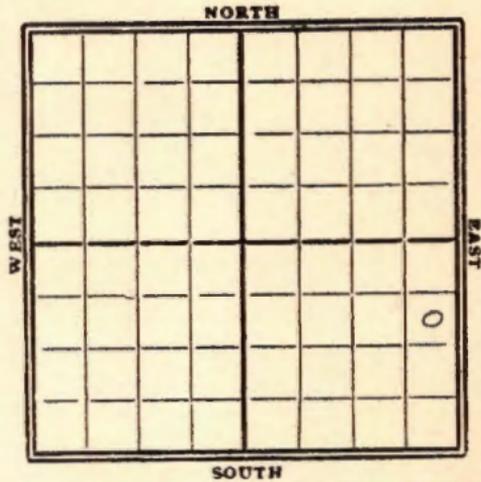

1929

Date	Prod.	REPORT
2/4	1091 bbl.	4/11 - 568 bbl.
2/8	1077 "	4/15 - Off -
2/16	1078 "	Will swab
2/20	1000 "	4/19 - 1039 bbl.
2/21	1070 "	
2/23	953 "	
2/26	929 "	
3/5	843 "	
3/7	1019 "	
3/8	833 "	
3/11	820 "	
3/12	796 "	
3/14	656 "	
3/16	755 "	
3/18	729 "	
3/19	731 "	
3/21	715 "	
3/22	744 "	
3/23	739 "	
3/25	700 "	
3/26	635 "	
3/28	640 "	

7/15 - Drilling 3105-

8/11 - " 3175

8/9 - Sand 3367-68

flow by heads - 50 bbls hr -

8/15 - Pay 3364-68

mkg. 1729 bbl 34 hrs

8/22 Pay 3364-68

Flow 1700 bbls.

# Comp.

8/15 - 1729 bbls	10/1 - 1672 bbls	11/14 - 1461 bbls
8/16 - 1703 "	10/2 - 1682 "	11/21 - 1400 "
8/17 - 1729 "	10/3 - 1687 "	11/22 - 1423 "
8/18 - 1708 1/2 "	10/7 - 1682 "	11/23 - 1405 "
8/19 - 1706 "	10/8 - 1680 "	11/24 - 1404 "
8/20 - 1700 "	10/9 - 1681 "	11/26 - 1364 "
8/21 - 1708 "	10/10 - 1682 "	11/27 - 1355 "
8/22 - 1700 "	10/11 - 1687 "	11/29 - 1557 "
8/23 - 1708 1/2 "	10/12 - 1681 "	11/30 - 1375 "
8/24 - 1687 1/2 "	10/13 - 1687 "	11/28 - 1348 "
8/25 - 1667 "	10/14 - 1687 "	12/1 - 1310 "
8/26 - 1687 "	10/15 - 1681 "	12/2 - 1305 "
8/27 - 1695 "	10/16 - 1670 "	12/3 - 1323 "
8/28 - 1692 1/2 "	10/17 - 1625 "	12/4 - 1320 "
8/29 - 1687 "	10/18 - 1619 "	12/5 - 1369 "
8/30 - 1667 "	10/19 - 1623 "	12/6 - 1245 "
8/31 - 1687 "	10/20 - 1619 "	12/7 - 1286 "
9/1 - 1687 1/2 "	10/21 - 1621 "	12/8 - 1295 "
9/2 - 1687 1/2 "	10/22 - 1562 "	12/9 - 1265 "
9/3 - 1687 1/2 "	10/23 - 1524 "	12/10 - 1262 "
9/4 - 1687 1/2 "	10/24 - 1555 "	12/11 - 1242 "
9/5 - 1682 "	10/25 - 1520 "	12/12 - 1248 "
9/6 - 1677 "	10/26 - 1520 "	<del>12/13 - 1656 "</del>
9/7 - 1687 "	10/27 - 1542 "	12/13 - 1242 "
9/8 - 1692 "	10/28 - 1524 "	12/14 - 1237 "
9/9 - 1687 1/2 "	10/29 - 1520 "	12/15 - 1208 ✓
9/10 - 1692 "	10/30 - 1536 "	12/16 - 1204 "
9/11 - 1692 "	10/31 - 1881 "	12/17 - 1229 "
9/12 - 1687 1/2 "	(300 bbls of this reserve)	12/18 - 1193 "
9/13 - 1682 "	Storage oil)	12/19 - 1199 "
9/14 - 1687 1/2 "	11/1 - 1606 bbls	12/20 - 1193 "
9/15 - 1687 1/2 "	11/2 - 1506 "	12/21 - 1200 "
9/16 - 1687 1/2 "	11/3 - 1500 "	12/29 - 1219 "
9/17 - 1687 "	11/4 - 1479 "	1/21 - 1109 "
9/18 - 1672 "	11/5 - 1461 "	1/25 - 1090 "
9/19 - 1682 "	11/8 - 1411 "	1/28 - 1219 "
9/20 - 1687 "	11/9 - 1391 "	1/28 - 1096 "
9/23 - 1686 "	11/20 - 1405 "	1/29 - 1088 "
9/24 - 1682 "	11/9 - 1471 "	2/1 - 1095 "
9/25 - 1687 "	11/10 - 1473 "	2/2 - 1086 "
9/26 - 1673 "	11/11 - 1461 "	
9/27 - 1667 "	11/12 - 1443 "	
9/28 - 1672 "	11/13 - 1461 "	
9/29 - 1687 "		
9/30 - 1687 "		

*Geological*  
*no. 1000*

MAP NO. KANSAS SEC. 12 TWP. 26 R. 1W

WELL NO. 1 Flight

Bu Vi Bar COMPANY

CONTRACTOR

SECTION PLAT

990 FT. FROM N. LINE

\_\_\_\_\_ FT. FROM S. LINE

330 FT. FROM E. LINE

\_\_\_\_\_ FT. FROM W. LINE

			0

COMPLETED

LOCATION \_\_\_\_\_

RIG UP \_\_\_\_\_

DRILLING AND REMARKS:

*Pay 3364-68*  
*Flowing*  
*1500 x 1/2*

RECORD

CASED \_\_\_\_\_ IN. \_\_\_\_\_ FT.

SAND \_\_\_\_\_

GAS \_\_\_\_\_

OIL \_\_\_\_\_

TOTAL DEPTH \_\_\_\_\_

PRODUCTION

1ST 24 HRS. NAT. \_\_\_\_\_

1ST 24 HRS. AFTER SHOT \_\_\_\_\_

GAS \_\_\_\_\_ CU. FT.

DRY HOLE \_\_\_\_\_

ABANDONED \_\_\_\_\_

DATE

AUG 22 1928

S. J. LEWIS

192

SCOUT

Map No. **KANSAS** Sec. 12 Twp. 26 R. 1W

Well No. 1 Knight

Gary D. Marland & Co Company

Contractor

**SECTION PLAT**

990 Ft. from N. Line

----- Ft. from S. Line

930 Ft. from E. Line

----- Ft. from W. Line

			0

**FIRST REPORTS**

Location

Rig up -----

Drilling and Remarks:

**RECORD**

Cased ----- in., ----- ft.

Sand -----

Gas -----

Oil -----

Total Depth -----

**PRODUCTION**

1st 24 hrs. Nat. -----

1st 24 hrs. after shot -----

Gas ----- Cu. Ft.

Dry Hole -----

Abandoned -----

Date

**MAR 7 1928**

**S. J. LEWIS**

Scout

no. 26-1M Bks. 3-23-11959.  
Sealywick  
no. 26-1M Bks. 3-23-11959.

Map No. \_\_\_\_\_ Sec. 12 Twp. 26 R. 1 W

Well No. 1 Wright

Bu. Hi. Bar Company

Contractor

SECTION PLAT

990 Ft. from N. Line

\_\_\_\_\_ Ft. from S. Line

300 Ft. from E. Line

\_\_\_\_\_ Ft. from W. Line

			0

Correction

Location \_\_\_\_\_

Rig up \_\_\_\_\_

Drilling and Remarks:

Reported this  
by Guy Oil Marland  
Edal  
Bu. Hi. Bar is  
going to operate  
this quarter

RECORD

Cased \_\_\_\_\_ in., \_\_\_\_\_ ft.

Sand \_\_\_\_\_

Gas \_\_\_\_\_

Oil \_\_\_\_\_

Total Depth \_\_\_\_\_

PRODUCTION

1st 24 hrs. Nat. \_\_\_\_\_

1st 24 hrs. after shot \_\_\_\_\_

Gas \_\_\_\_\_ Cu. Ft.

Dry Hole \_\_\_\_\_

Abandoned \_\_\_\_\_

Date

7/11 1928 S. J. Lewis Scout