

Sedgwick

Map No. **KANSAS** Sec. *12* Twp. *26* R. *TW*

Well No. *6-1/2 Wright* Farm

Bu-Ti-Ball et al Company

NORTH

							0

WEST

EAST

SOUTH

Location.....

Drilling Remarks

.....

.....

Rig Up.....

Drilling Remarks

.....

.....

RECORD

Cased..... in..... ft.

Sand.....

Gas.....

Oil.....

Total Depth.....

PRODUCTION

1st 24 hrs. Nat.....

1st 24 hrs. after shot.....


Gas..... cu. ft.....

Dry Hole.....

Abandoned.....

Sedgwick
 Map No. **KANSAS** Sec. 12 Twp. 26 R. 1W
 Well No. 6-Brigit Farm
Ben-Vi-Bar et al Company

330 Ft. from N. Line
 _____ Ft. from S. Line
330 Ft. from E. Line
 _____ Ft. from W. Line

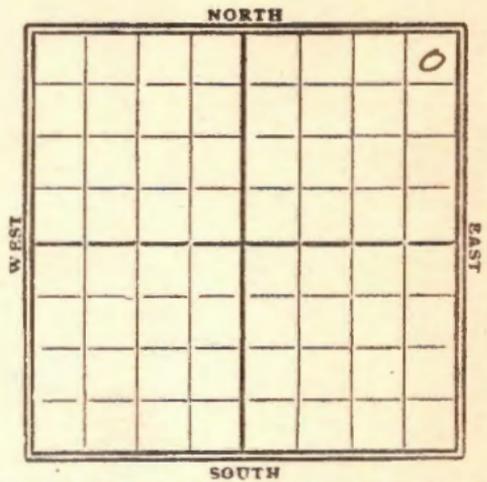

1929

Date	REPORT
5/8	Location
5/15	Rig
5/22	Rignup
5/29	Spud 215'
6/5	Perlg 1270
6/12	" 1595
6/19	" 2415
6/26	" 2920
7/2	Baseline 3260
7/10	8" - 3310 Perm 8" - 3310'
7/17	SD 3352'
7/24	Trimp 3358-63 TID 3363 swab 330 bbl oil 5 amp.

Belgwick

Map No. **KANSAS** Sec. *12* Twp. *26* R. *1W*

Well No. *6 Wright*

Bu Vi Par et al Company

Contractor

SECTION PLAT

330 Ft. from N. Line

Ft. from S. Line

330 Ft. from E. Line

Ft. from W. Line

			0

FIRST REPORTS

Location *[checkmark]*

Rig up

Drilling and Remarks:

RECORD

Cased in., ft.

Sand

Gas

Oil

Total Depth

PRODUCTION

1st 24 hrs. Nat.

1st 24 hrs. after shot

Gas Cu. Ft.

Dry Hole

Abandoned

Date

MAY 8 1929

192

S. J. LEWIS

Scout

Map No. **KANSAS** Sec. 12 Twp. 26 R. 1W

Well No. 6 Wright

Bu Vi Bar et al Company

Contractor

SECTION PLAT

330 Ft. from N. Line

..... Ft. from S. Line

330 Ft. from E. Line

..... Ft. from W. Line

			0

COMPLETED

Location.....

Rig up.....

Drilling and Remarks:

Super 3357
3363

Swat 3308

RECORD

Cased..... in.,ft.

Sand.....

Gas.....

Oil.....

Total Depth 3363

PRODUCTION

1st 24 hrs. Nat.....

1st 24 hrs. after shot.....

Gas..... Cu. Ft.

Dry Hole.....

Abandoned.....

Date

JUL 24 1929

192

S. J. LEWIS Scout