

Sedgwick

Map No. **KANSAS** Sec. 12 Twp. 26 R. 1W

Well No. 7- Thrift Farm


~~W. Vi-Bar et al~~ Company
Continental & Gulf

288 Ft. from N. Line

_____ Ft. from S. Line

1060 Ft. from E. Line

_____ Ft. from W. Line

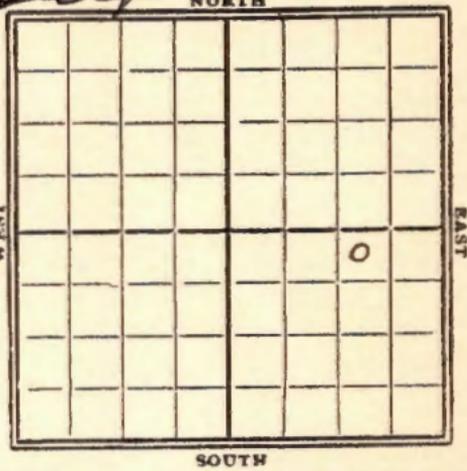

1929

Date REPORT **O. W. D. D**

7/10	Peak	
7/17	Reg. sup.	
7/24	Wdg.	1545'
7/31	"	1330'
8/7	"	2030'
	"	2670
8/14	show	C-2560-65
8/21	Reg	3050'
8/28	8"-3050	Cement
9/4	Wdg	3260
9/11	sand	3361-65
		T.D. 3365'
	swab	897 bbl oil
		5 omp.

OVER

1936

11/25 Old T. D. 3365'.

Viola 3359 Simpson 3377'.

Sil. 3462'. Basil Sand 4173'.

Granite 4190'. T. D. 4275'.

Water disposal well.

5000 bbls. water a day.

FIRST REPORTS

and

ABANDONED

39

Map No. **KANSAS** Sec. 12 Twp. 26 R. 1 W

Well No. 7 Knight

Burke & Bar Company
Contractor

SECTION PLAT

288 Ft. from N. Line

_____ Ft. from S. Line

1060 Ft. from E. Line

_____ Ft. from W. Line

			0

FIRST REPORTS

Location _____

Rig up _____

Drilling and Remarks;

*Rotary
Rigging up.*

RECORD

Cased _____ in., _____ ft.

Sand _____

Gas _____

Oil _____

Total Depth _____

PRODUCTION

1st 24 hrs. Nat. _____

1st 24 hrs. after shot _____

Gas _____ Cu. Ft.

Dry Hole _____

Abandoned _____

Date

JUL 10 1929

S. J. LEWIS

Scout

KANSAS

Map No. 39 Sec. 12 Twp. 26 R. 1W

Well No. 7 Wright

Bu Ni Bar & Sal Company

Contractor

SECTION PLAT

			o

288 Ft. from N. Line

..... Ft. from S. Line

1060 Ft. from E. Line

..... Ft. from W. Line

COMPLETED

Location.....

Rig up.....

Drilling and Remarks:

Sway 8978/8

RECORD

Cased..... in., ft.

Sand 3361-65

Gas.....

Oil.....

Total Depth 3365

PRODUCTION

1st 24 hrs. Nat.....

1st 24 hrs. after shot.....

Gas..... Cu. Ft.

Dry Hole.....

Abandoned.....

Date

SEP 1 1 1929

S. J. LEWIS

Map No. 39 Sec. 12 Twp. 26 R. 1W

Well No. 7 Wright

Continental & Gulf Company

(CORRECTION) Contractor

(Company name and feet measurements) SECTION PLAT

220 Ft. from N. Line

Ft. from S. Line

990 Ft. from E. Line

Ft. from W. Line

			0

ABANDONED

FIRST REPORT

ABANDONED DWIT O. W. D. D

Location

Rig up

Drilling and Remarks:

Old 703365
 Viola 3359
 Simpson 3399
 Oil 3462.
 Basil Sand 4173
 Granite 4190
 5000 gals water per day
 water disposal well

Date

RECORD

Cased in., ft.

Sand

Gas

Oil

Total Depth 4275

PRODUCTION

1st 24 hrs. Nat.

1st 24 hrs. after shot

Gas Cu. Ft.

Dry Hole

Abandoned

NOV 25 1936

S. J. LEWIS

Scout