


Map No. **KANSAS** Sec. 12 Twp. 26 R. 1^W

Well No. 8-9 Bright Farm
Bu-Vi-Bar et al Company

NORTH

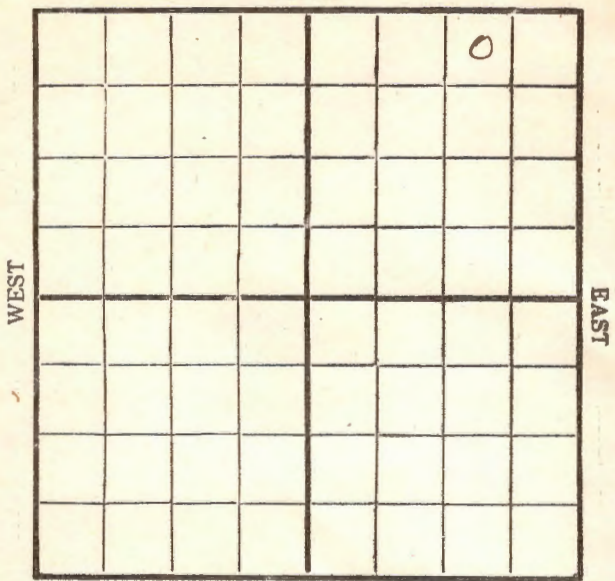

SOUTH

Location _____

Drilling Remarks _____

Rig Up _____

Drilling Remarks _____

RECORD

Cased _____ in. _____ ft.

Sand _____

Gas _____

Oil _____

Total Depth _____

PRODUCTION

1st 24 hrs. Nat. _____

1st 24 hrs. after shot _____


Gas _____ cu. ft. _____

Dry Hole _____

Abandoned _____

Map No. **KANSAS** Sec. 12 Twp. 26 R. 1^w
Well No. 8 - Bright Farm
Bou-Vi-Barrel et al Company

330 Ft. from N. Line
 Ft. from S. Line
990 Ft. from E. Line
 Ft. from W. Line

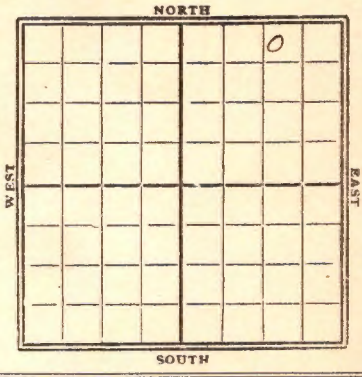

1929

Date REPORT

8/7 set 15 1/2" - 220'
8/14 nearly 1050
8/21 " 1775
8/28 " 2500
9/4 3015 - LWR 8"
9/11 nearly 3210
9/18 6" - 3352'
9/25 sand 3370 - 75'
T.D. 3375'
swab 511 bbl oil
Pump

39 **KANSAS** Sec. 12 Twp. 26 R. 1 W

Well No. 8 Wright

Bi-li-Bar Etal Company

Contractor

FIRST REPORTS

SECTION PLAT

330 Ft. from N. Line

Ft. from S. Line

990 Ft. from E. Line

Ft. from W. Line

			0

Location

Rig up

Drilling and Remarks:

Set 15 1/2" 280'

RECORD

Cased.....in.,ft.

Sand.....

Gas.....

Oil.....

Total Depth.....

PRODUCTION

1st 24 hrs. Nat.....

1st 24 hrs. after shot.....

Gas.....Cu. Ft.

Dry Hole.....

Abandoned.....

Date

AUG 7 1929 192

CHAS. L. SHERWOOD

Scout

Map No. **KANSAS** Sec. 12 Twp. 26 R. 11

Well No. 8 Wright

Bur-Vi Bar & Oil Company

Contractor

SECTION PLAT

330 Ft. from N. Line

..... Ft. from S. Line

990 Ft. from E. Line

..... Ft. from W. Line

			0

COMPLETED

Location.....

Rig up.....

Drilling and Remarks:

Swath 511876

RECORD

Cased..... in., ft.

Sand 3320-25

Gas.....

Oil.....

Total Depth 3325

PRODUCTION

1st 24 hrs. Nat.....

1st 24 hrs. after shot.....

Gas..... Cu. Ft.

Dry Hole.....

Abandoned.....

Date

SEP 25 1929

192

S. J. LEWIS Scout