


Map No. _____ Sec. 26 Twp. 26 R. 1^W
Well No. 1 Alex Farm _____
Regan-Roper & Evans Company

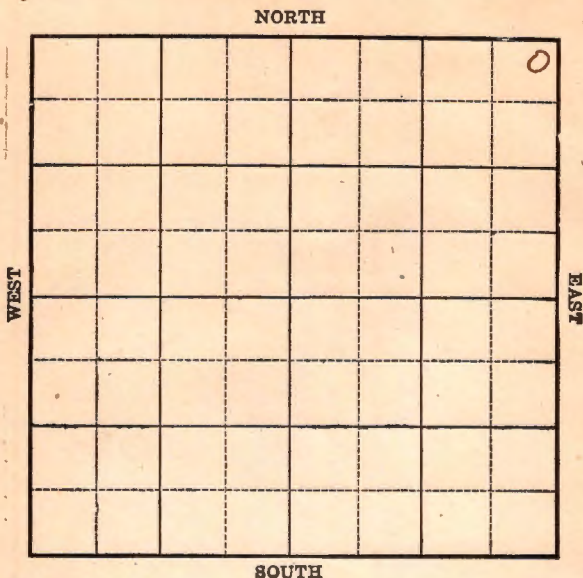

Location _____

Drilling Remarks:

Rig up _____

Drilling Remarks:

RECORD

Cased _____ in. _____ ft.

Sand _____

Gas _____

Oil _____

Total Depth _____

PRODUCTION

1st 24 hrs Nat. _____

1st 24 hrs. after shot _____

Gas _____ cu. ft.

Dry Hole _____


Abandoned _____

Map No. _____ Sec. 26 Twp. 26 R. 1 WWell No. 1 Alley FarmRegan, Rafer & Evans Company200 Ft. from N. Line

_____ Ft. from S. Line

200 Ft. from E. Line

_____ Ft. from W. Line

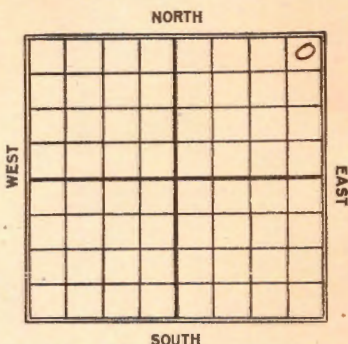Date
1923

REPORT

5/19 Apud.10/27 Sp. at 3000'

1924

1/15 D & d 9-3230'

Map No. **KANSAS** Sec. **26** Twp. **26** R. **11N**

Well No. **1** *Regan* *Reaper & Evans* Company

Contractor

FIRST REPORT

SECTION PLAT

200 Ft. from N. Line

Ft. from S. Line

200 Ft. from E. Line

Ft. from W. Line

			0

Location

Rig up

Drilling and Remarks:

spind

RECORD

Cased in, ft.

Sand

Gas

Oil

Total Depth

PRODUCTION

1st 24 hrs. Nat.

1st 24 hrs. after shot

Gas Cu. Ft.

Dry Hole

Abandoned

Date **MAY 19 1923**

M. A. BENEAR

192

Scout

Map No. **KANSAS** No. **26** Sec. **26** Twp. **26** R. **1W**

Well No. **#1** *Alley*
Regan Raper & Evans Company

Contractor

BANDONED

SECTION PLAT

200' Ft. from N. Line

_____ Ft. from S. Line

200' Ft. from E. Line

_____ Ft. from W. Line

Location _____

Rig up _____

Drilling and Remarks:

*LOG 3230'***RECORD**

Cased _____ in., _____ ft.

Sand _____

Gas _____

Oil _____

Total Depth _____

PRODUCTION

1st 24 hrs. Nat. _____

1st 24 hrs. after shot _____

Gas _____ Cu. Ft.

Dry Hole _____

Abandoned _____

Date

JAN 18 1924

M. A. BENEAR

192_____

Scout

MAP No. _____ SEC. 26 TWP. 36 S R. 1WELL No. 1 AlleyBayer + Rayner _____ CON

CONTRACT

SECTION PLAT

_____ FT. FROM N. LINE

_____ FT. FROM S. LINE

_____ FT. FROM E. LINE

_____ FT. FROM W. LINE

LOCATION _____

RIG UP _____

DRILLING AND REMARKS:

*OK with
our walling*

RECORD

CASED _____ IN. _____ FT.

SAND _____

GAS _____

OIL _____

TOTAL DEPTH 3530

PRODUCTION

1ST 24 HRS. NAT. _____

1ST 24 HRS. AFTER SHOT _____

GAS _____ CU. FT.

DRY HOLE ☒ABANDONED ☒

DATE

1/5 192 4

SCOUT