


Sedgwick

Map No. **KANSAS** Sec. 1 Twp. 26 R. 1W

Well No. 4 - Parr Farm _____
Bee-Vi-Bar et al Company

330 Ft. from N. Line
_____ Ft. from S. Line
_____ Ft. from E. Line
990 Ft. from W. Line

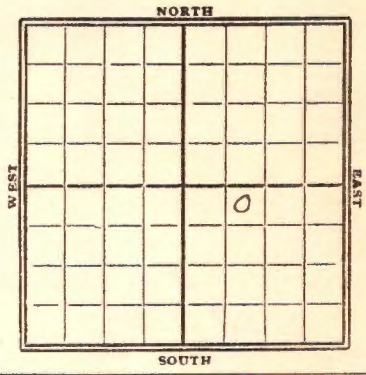

1929

Date

REPORT

4/24	Location
5/1	Rigging up
5/8	Spud 180'
5/15	url 1411'
5/22	" 2311
5/29	" 3011
6/5	" 3300 8" = 3300
6/12	Simpson 3350-61'
	T.D. 3361'
	swab 1005 bbls
	Comp.

Map No. **KANSAS** Sec. 1 Twp. 26 R. 11

Well No. 4 Com

Burt Barstad Company

Contractor

SECTION PLAT

330 Ft. from N. Line

..... Ft. from S. Line

..... Ft. from E. Line

990 Ft. from W. Line

		0	

FIRST REPORTS

Location ✓

Rig up

Drilling and Remarks:

RECORD

Cased.....in.,ft.

Sand.....

Gas.....

Oil.....

Total Depth.....

PRODUCTION

1st 24 hrs. Nat.....

1st 24 hrs. after shot.....

Gas.....Cu. Ft.

Dry Hole.....

Abandoned.....

Date

APR 24 1929
.....192.....

S. J. LEWIS Scout

Map No. **KANSAS** Sec. 1 Twp. 26 R. 14

Well No. 4 Cor

Burke Bros Edg Company

Contractor

SECTION PLAT

320 Ft. from N. Line

..... Ft. from S. Line

..... Ft. from E. Line

990 Ft. from W. Line

		o	

COMPLETED

Location.....

Rig up.....

Drilling and Remarks:

Swamp 3350-
3361

Swamp 10058

RECORD

Cased..... in., ft.

Sand.....

Gas.....

Oil.....

Total Depth 3361

PRODUCTION

1st 24 hrs. Nat.....

1st 24 hrs. after shot.....

Gas..... Cu. Ft.

Dry Hole.....

Abandoned.....

Date

JUN 12 1929

192

S. J. LEWIS

Scout