

Map No. **KANSAS** Sec. 1 Twp. 26 R. 1W

Well No. 3 - Reed Farm


Bu-Vi-Bar et al Company

.....Ft. from N. Line

330 Ft. from S. Line

990 Ft. from E. Line

.....Ft. from W. Line

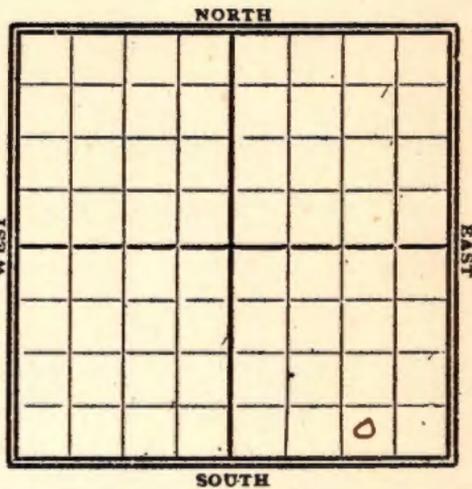

1929

Date

REPORT

6/12

Rig

6/19

Rig up

6/26

serly 1440

7/2

" 2335

7/10

" 3198

7/17

sep 8" - 3307

7/24

Strip 3363-71

TD 3371

swab 1044 bbl
Comp.

Map No. **KANSAS** Sec. 1 Twp. 26 R. 1W

Well No. 39 3 Reed

Burke Bas & Co Company

Contractor

SECTION PLAT

..... Ft. from N. Line

300 Ft. from S. Line

990 Ft. from E. Line

..... Ft. from W. Line

FIRST REPORTS

Location.....

Rig up.....

Drilling and Remarks:

Rig

RECORD

Cased..... in., ft.

Sand.....

Gas.....

Oil.....

Total Depth.....

PRODUCTION

1st 24 hrs. Nat.....

1st 24 hrs. after shot.....

Gas..... Cu. Ft.

Dry Hole.....

Abandoned.....

Date

JUN 12 1929

192.....

S. J. LEWIS

Scout

Map No. **KANSAS** Sec. 1 Twp. 26 R. 1W

Well No. 3 Reed

Bu Vi Bar et al Company

Contractor

SECTION PLAT

			0

.....Ft. from N. Line

380 Ft. from S. Line

990 Ft. from E. Line

.....Ft. from W. Line

COMPLETED

Location.....

Rig up.....

Drilling and Remarks:

Simpson 3363-7

Swatt 1044 1/2

RECORD

Cased.....in.,ft.

Sand.....

Gas.....

Oil.....

Total Depth 3271

PRODUCTION

1st 24 hrs. Nat.....

1st 24 hrs. after shot.....

Gas.....Cu. Ft.

Dry Hole.....

Abandoned.....

Date

JUL 24 1929

192.....

S. J. LEWIS

Scout